

Kearny


KANSAS

SECTION 20 TOWNSHIP 23 RANGE 37 W

WELL NO. #1 Leucks Gas Unit "B"

COMPANY Stanolind

NORTH

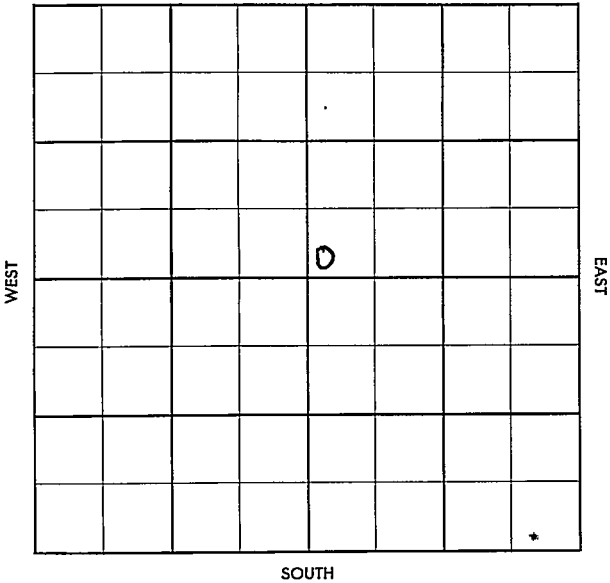

Kearny

KANSAS

SEC.	TWP.	R.
20	23	37W

WELL NO.

#1 Laucks Gas Unit "B"

FARM

COMPANY

Stanolind

CONTRACTOR

Hugoton

Ft. from N. Line

150


Ft. from S. Line

Ft. from E. Line

150

Ft. from W. Line

SW SW NE

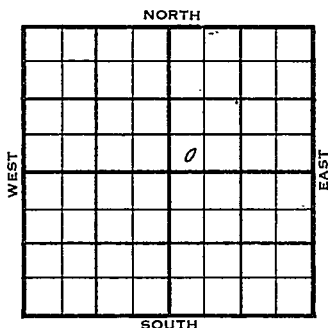

1956

ELEVATION

3294 GF, 3296 DF, 3299 RB

REPORT

1-18

Location

FORM 513 REV. SUNRAY

3294 GF

3296 DF

3299 RB

County

Keeney

Elev.

Sec.

20

Twp.

23

Rge.

37W

Company

Stanolind

FarmName

Laucks Gas Unit "B" No. 1

TOPS

DEPTH

LOG

DATUM

Loc. in Sec.

Anh.

SW SW NE

Tp.

H.

150' SL

Tr.

Dg.

150' WL

Bl.

L.

K.C.

Geol.

B.K.C.

Contr.

Ce.

C.

M.

Pool

M.

K.

Higoton

Mz.

Mq.

V.

S.

S.

A.

R.

Pe.

G.

T.D.

JAN 18 '56

FIRST REPORT

Date Comm.

Location

34

3294 GF

3295 DF

3299 RB

County Kearny

Elev.

Sec. 20Twp. 23Rgn. 37WCompany StanolindFarm Name Lancks Gas Unit "B" No. 1

TOPS	DEPTH	LOG	DATUM	Loc. in Sec.
Asb				
Tp <u>Herr</u>	<u>2564</u>			<u>SW SW NE</u>
H. <u>WEd</u>	<u>2616</u>			<u>150' SL</u>
Tp <u>Tow</u>	<u>2680</u>			<u>150' WL</u>
Dp <u>ETRLy</u>	<u>2717</u>			
Bl.				
L.				
K.C.				Geol. _____
BKC.				Contr. _____
Co.				
C.				
M.				
M.				Pool _____
K.				<u>Engoton</u>
Ne.				
V.				
S.				
S.				
A.				
R.				
PC				
C.				
TS	<u>2740</u>			<u>COMPLETE</u>

Date Comm.

FEB 15 1956

Location JAN 25 '56 ✓ FEB 1 '56 1-24-56878 225 / 500 5' 22738 / 1000FEB 8 '56 CO 2732 24 / 2718-24FRAC 9A 285 MCF FEB 15 '56 PB2705 @ 16 / 2692-96 20 / 2681-86 16 / 2674-78 FRAC CO2732 9A 260 MCF PB 260612 / 2592-95 16 / 2582-86 24 /2566-72 55G FRAC CO 2732

20" op F/W 6,598 MCF
SIP 363 #

R.G.

FEB 27 1956