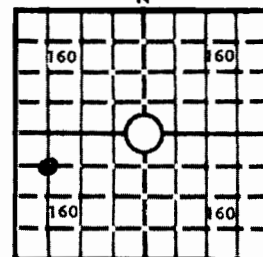


KANSAS

WELL COMPLETION REPORT AND
DRILLER'S LOGState Geological Survey
WICHITA BRANCHAPI No. 15 — 083 — 20,864
County NumberS. 29 T. 23S R. 21W
C NW SW

County Hodgeman

640 Acres
N

Locate well correctly

Elev.: Gr. 2340

DF KB 2344

Operator
VINCENT OIL CORPORATIONAddress
230 O. W. Garvey Bldg.; Wichita, KS 67202

Well No. #1 Lease Name AISTRUP

Footage Location

feet from (N) (S) line

feet from (E) (W) line

Principal Contractor
White & Ellis DrillingGeologist
Chuck SchmaltzSpud Date
7/1/81Date Completed
7/13/81Total Depth
4675'

P.B.T.D.

Directional Deviation

Oil and/or Gas Purchaser

CASING RECORD

Report of all strings set — surface, intermediate, production, etc.

Purpose of string	Size hole drilled	Size casing set (in O.D.)	Weight lbs/ft.	Setting depth	Type cement	Sacks	Type and percent additives
Surface		8 5/8"		356'		275	2% gel, 3%CC

LINER RECORD

PERFORATION RECORD

Top, ft.	Bottom, ft.	Sacks cement	Shots per ft.	Size & type	Depth interval

TUBING RECORD

Size	Setting depth	Packer set at			


ACID, FRACTURE, SHOT, CEMENT SQUEEZE RECORD

Amount and kind of material used	Depth interval treated

INITIAL PRODUCTION

Date of first production NONE	Producing method (flowing, pumping, gas lift, etc.)
RATE OF PRODUCTION PER 24 HOURS	Oil bbls. Gas MCF Water bbls. Gas-oil ratio CFPB
Disposition of gas (vented, used on lease or sold)	Producing interval (s)

INSTRUCTIONS: As provided in KCC Rule 82-2-125, within 90 days after completion of a well, one completed copy of this Drillers Log shall be transmitted to the State Geological Survey of Kansas, 4150 Monroe Street, Wichita, Kansas 67209. Copies of this form are available from the Conservation Division, State Corporation Commission, 245 No. Water, Wichita, Kansas 67202. Phone AC 316-522-2206. If confidential custody is desired, please note Rule 82-2-125. Drillers Logs will be on open file in the Oil and Gas Division, State Geological Survey of Kansas, Lawrence, Kansas 66044.

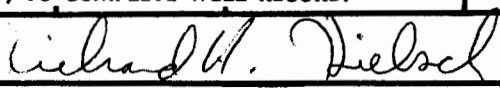Operator VINCENT OIL CORPORATION		DESIGNATE TYPE OF COMP.: OIL, GAS, DRY HOLE, SWDW, ETC.: dry hole	
Well No. #1	Lease Name Aistrup		
S <u>29</u> T <u>23S</u> R <u>21W</u> <u>R</u> <u>W</u>			
WELL LOG		SHOW GEOLOGICAL MARKERS, LOGS RUN, OR OTHER DESCRIPTIVE INFORMATION.	
Show all important zones of porosity and contents thereof; cored intervals, and all drill-stem tests, including depth interval tested, cushion used, time tool open, flowing and shut-in pressures, and recoveries.			
FORMATION DESCRIPTION, CONTENTS, ETC.	TOP	BOTTOM	NAME
			ELECTRIC LOG TOPS:
Cellar	0	5	Anhydrite 1436 (+ 908)
Sandy Shale, Lime	5	367	Heebner 3926 (-1582)
Sandy Shale	367	902	Lansing 4022 (-1678)
Sand	902	994	Base K.C. 4369 (-2025)
Shale, Lime	994	1432	Marmaton 4396 (-2052)
Anhydrite	1432	1458	Ft. Scott 4541 (-2197)
Shale	1458	2084	Cherokee Shale 4568 (-2224)
Shale, Lime	2084	2731	Erosional Miss. 4605 (-2261)
Lime	2731	2820	Miss. Osage 4654 (-2310)
Lime, Shale	2820	3801	LTD 4674
Lime	3801	4503	
Lime, Shale	4503	4581	
Lime	4581	4675	
DST #1 - 4364'-4445', Open 60", shut in 60", open 60", shut in 75". Weak blow increasing to strong on both flow periods. Recovered 90 ft. gas in pipe, 155 ft. very heavy oil cut mud (2% gas, 40% mud, 8% water, 50% oil), Hydrostatic pressure 2189 - 2169.			
IFP - 102-122#	ISIP - 1223#		
FFP - 133-153#	FSIP - 1223#		
DST #2 - 4519'-4590', Open 30", shut in 30", open 30", shut in 30". Recovered 15 ft. mud. Hydrostatic pressure 2336-2326.			
IFP - 42-42#	ISIP - 144#		
FFP - 52-52#	FSIP - 73#		
DST #3 - 4586'-4638', Open 30", shut in 30", open 30", shut in 30". Recovered 90 ft. mud, (CL 24,000, Mud CL 10,000) Hydrostatic pressure 2389 - 2368.			
IFP - 62-62#	ISIP - 685#		
FFP - 83-83#	FSIP - 562#		
USE ADDITIONAL SHEETS, IF NECESSARY, TO COMPLETE WELL RECORD.			
Date Received	 Signature Vice President Title August 10, 1981 Date		

29-23-21W

State Geological Survey
DRILLERS LOG WICHITA BRANCH

OPERATOR: Vincent Oil Corp. Suite 230 O.W. Garvey Bldg. Wichita, Ks. 67202

CONTRACTOR: **White & Ellis Drilling, Inc., Box 448, El Dorado, Kansas 67042**

Lease Name Aistrup Well No. #1

Sec. 29 T. 23 R. 21W Spot C NW SW

County Hodgeman State Kansas Elevation _____

Casing Record:

Surface: 8 5/8 @ 363' with 275 Sxs.

Production: _____ @ _____ with _____ Sxs.

Type Well: D & A Total Depth 4675'

Drilling Commenced: 7-1-81 Drilling Completed 7-13-81

Formation	From	To	Tops
Cellar	0	5	
Sandy Shale, Lime	5	367	
Snady Shale	367	902	
Sand	902	994	
Shale, Lime	994	1432	
Anhydrite	1432	1458	
Shale	1458	2084	
Shale, Lime	2084	2731	
Lime	2731	2820	
Lime, Shale	2820	3801	
Lime	3801	4503	
Lime, Shale	4503	4581	
Lime	4581	4675	

COMPLETION RECORD

Liner Record: Size _____ From _____ To _____

Cementing Record: _____ Sacks _____

Perforating Record: _____