

Section 21 Township 23 Range 1W

Well No. 1 Pierce

Company Shawver - Graham

Wildcat

NORTH

WEST

EAST


SOUTH

0

Sec. 21 Twp. 23 R. 1-W

Well No. #1 Pierce Farm
Shawver- Graham Company
Wildcat

 Ft. from N. Line
330 Ft. from S. Line
 Ft. from E. Line
330 Ft. from W. Line
 SW SE

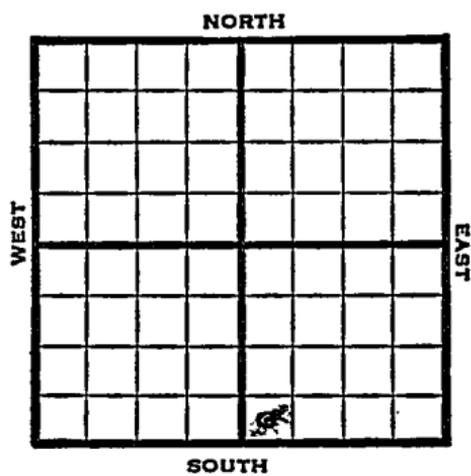

1949 Elev 1413' REPORT

1/26 2/2 2/9 2/16 2/23	RUR " 8" @ 240' Drlg. 2475' Lansing 3360' Misner 3435' Viola 3540' Drlg. 3639' TD 3693' Arb. 3655' Aband. ABANDONED	Miss 3042' Hunton 3436' Simpson 3579'
--	---	---

Map No. _____ Sec. 21 Twp. 23 R. 1W

Well No. 1 Pierce

Shawver - Graham Company

FIRST REPORT

Contractor

SW SE

SECTION PLAT

_____ Ft. from N. Line

330 Ft. from S. Line

_____ Ft. from E. Line

330 Ft. from W. Line

Harvey County

Location _____

Rig up _____

Drilling and Remarks:

R U R

RECORD

Cased _____ in., _____ ft.

Sand _____

Gas _____

Oil _____

Total Depth _____

PRODUCTION

1st 24 hrs. Nat. _____

1st 24 hrs. after shot _____

Gas _____ Cu. Ft.

Dry Hole _____

Abandoned _____

Date

JAN 26 1949 19

S. I. LEWIS Scout

Kansas

Map No. K 29 Sec. 21 Twp. 23 R. 1W

Well No. 1 Pierce

Shawver - Graham Company

ABANDONED Contractor

SW SE

E 11413
SECTION PLAT

_____ Ft. from N. Line

330 Ft. from S. Line

_____ Ft. from E. Line

330 Ft. from W. Line

Harvey County

Location _____

Rig up _____

Drilling and Remarks:

Per 13655

RECORD

Cased _____ in., _____ ft.

Sand _____

Gas _____

Oil _____

Total Depth 2629

PRODUCTION

1st 24 hrs. Nat. _____

1st 24 hrs. after shot _____

Gas _____ Cu. Ft.

Dry Hole _____

Abandoned _____

Date

FEB 23 1949 19

S. J. LEWIS Scout