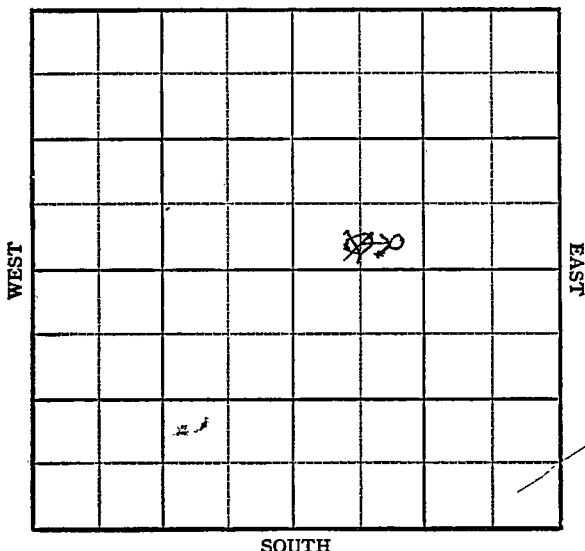


Section 21 Township 23 Range 3WWell No. 1 JonesCompany B & R Drlg.Wildcat
NORTH

KANSAS

Harvey

Sec. 21 Twp. 23 R. 3W ✓

Well No. #1 Jones Farm

B & R Drlg. Company

Wildcat

 Ft. from N. Line


330'

 Ft. from S. Line

 Ft. from E. Line

660'

 Ft. from W. Line

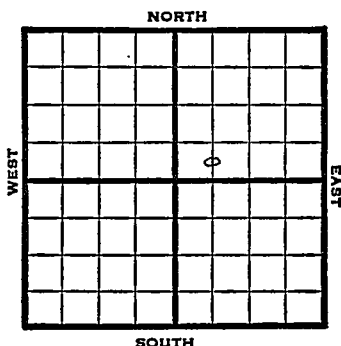

~~C S L SW NE~~
SE SW NE

1948

Elev 1449' REPORT

10/20 Surface Hole

10/26 8" @ 257'

Drlg. 2545'

11/3 5" @ 3363'

11/10 "

11/16 "

11/23 "

11/30 "

12/6 "

12/14 "

12/22 "

12/29 "

1949

1/12

TD 3363'

Miss 3257'

5" @ 3363'

Perf

2,800,000 Gas

Comp

COMPLETED

Map No. _____ Sec. 21 Twp. 23 R. 3W

Well No. 1 Jones

_____ B & R Drlg. _____ Company

FIRST REPORT

_____ Contractor

C S L SW NE


SECTION PLAT

_____ Ft. from N. Line

330 Ft. from S. Line

_____ Ft. from E. Line

660 Ft. from W. Line

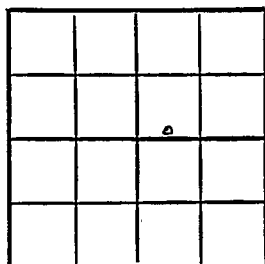

Harvey County

Location _____

Rig up _____

Drilling and Remarks:

surface hole

RECORD

Cased _____ in., _____ ft.

Sand _____

Gas _____

Oil _____

Total Depth _____

PRODUCTION

1st 24 hrs. Nat. _____

1st 24 hrs. after shot _____

Gas _____ Cu. Ft.

Dry Hole _____

Abandoned _____

Date

OCT 20 1948

19

S. J. LEWIS

Scout

Map No. 39 Sec. 21 Twp. 23 R. 3WWell No. 1 Jones


B & R Drlg. Company

CORRECTION

Contractor

SE SW NE

SECTION PLAT

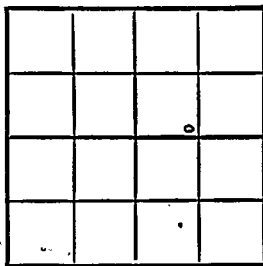 Ft. from N. Line330 Ft. from S. Line Ft. from E. Line990 Ft. from W. Line

Harvey County

Location Rig up Drilling and Remarks:

Reported

C S L SW NE

RECORD

Cased in., ft.Sand Gas Oil Total Depth

PRODUCTION

1st 24 hrs. Nat. 1st 24 hrs. after shot Gas Cu. Ft.Dry Hole Abandoned

Date

OCT 27 1948

19

S. J. LEWIS

Scout

Kansas

Wildcat

Map No. 39 Sec. 21 Twp. 23 R. 3 WWell No. 1 Jones


B & R Drlg.

Company

COMPLETE

Contractor

SE SW NE

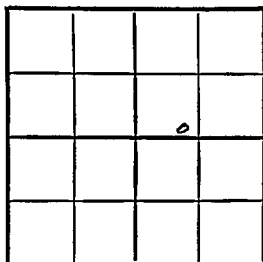E 11449
SECTION PLAT Ft. from N. Line330 Ft. from S. Line Ft. from E. Line990 Ft. from W. LineHarvey County325

RECORD

Location Cased in., ft.Rig up Sand

Drilling and Remarks:

Gas ✓Oil Total Depth 3863

PRODUCTION

1st 24 hrs. Nat. 1st 24 hrs. after shot Gas Cu. Ft.Dry Hole Abandoned

Date

JAN 12 1949

19

S. J. LEWIS

Scout

Mis 32575 "C 3363Pay2,800,000 Gals