


Section 21 Township 23 Range 5W

Well No. 1 C. F. Swanson

Company Brooks Pierce

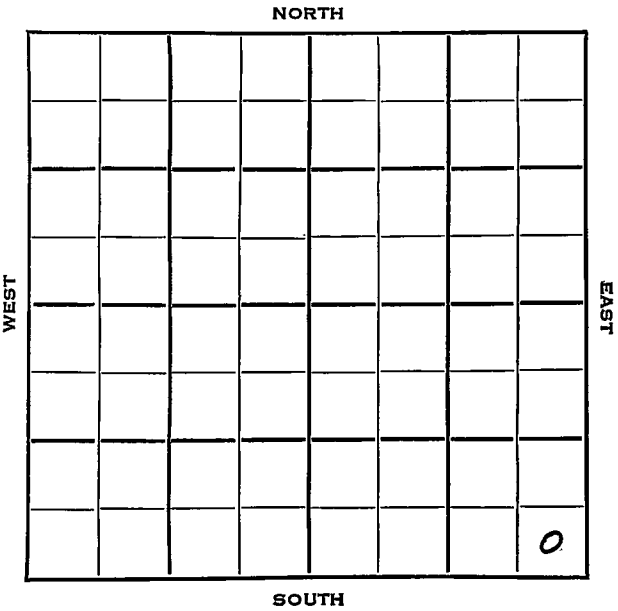

KANSAS

SEC.	TWP.	R.
21	23	5W ✓

WELL NO.

#1 C.F. Swanson

FARM

COMPANY

Brooks Pierce

CONTRACTOR

Tom Allen

Wildcat. NORTH

NORTH

Ft. from N. Line

330 Ft. from S. Line

330 Ft. from E. Line

Ft. from W. Line

SE SE SE

1954	ELEVATION 1514'	REPORT
3/24	Spud 3-19-54 14" @ 90' 8" @ 749'	
3/31	Drlg 1045' Drlg 3242'	
4/7	Heeb 2507', Lans 2718', Warsaw 2390' Osage 3400' DST 3393'-3455' 1 hr, 1470' SW 890# Kh. 3622', Meisner 3738', Htn 3743' Mg. 3776', V 3847' Simp 3871' Drlg 3927'	
4/14	Spud 3-19-54 D&A TD 3975' 14" @ 90' 8" @ 749' Heeb 2507', Lans 2718', Warsaw 2390', Osage 3400' DST 3393-3455', opn 1 hr., rec. 1470' SW, 890# Kh. 3622', Meisner 3738', Hunton 3743' Maq. 3776', Viola 3847', Simp 3871', Krb. 3956' TD 3975' D&A	
ABANDONED		

DX-78

DX-78


County Reno State Kans
 Sec. 21 (Blk. Twp.) 23 (Sur. Rge.) 5W Map No.
 Operator Brooks Pierce
 Well No. 1 Farm C. F. Swanson
 Elev. Location SE SE SE



330 Ft. From S Line SE
330 Ft. From E Line Quarter
 1st. Report MAR 24 1954
 Completion
 Remarks
Tom Allen - Contr.
 Spudding Date 3-19-54

Drlg. Data Wildcat

14" @ 90 8" @ 749 drlg. 1045

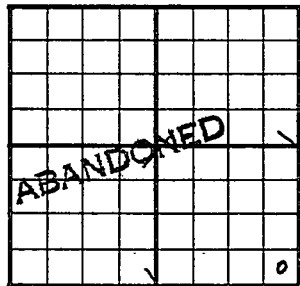County Reno State KansasSec. 21 (Blk.
Twp.) 23 (Sur.
Rge.) 5W Map No.Operator Brooks PierceWell No. 1 Farm C. F. SwansonElev. 1514 Location SE SE SE330 Ft. From S Line SE330 Ft. From E Line Quarter

1st. Report

Completion APR 14 1954Remarks WildcatTom Allen - Contr.Spudding Date 3-19-54Drlg. Data D & A TD 397514" @ 90 8" @ 749 Heeb. 2507Lans. 2718 Warsaw 2390 Osage 3400DST 3393-3455 open 1 hr. Rec. 1470' sw890# Kh. 3622 Meisner 3738 Hunton 3743Maq. 3776 Viola 3847 Simp. 3871Arb. 3956 TD 3975D & A