

# KANSAS

FORM 51 5M 4-41 PETROL


Reno

Section 21 Township 23 Range 10-W

Well No. 1 Kreie "C"

Company Cities Service Oil

NORTH Peace Creek pool

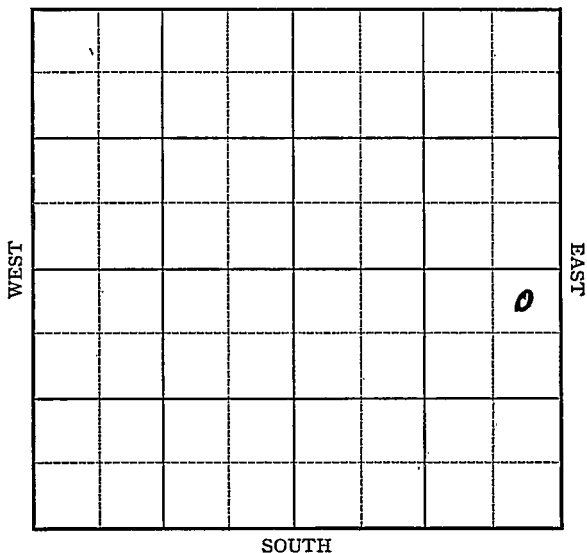

Sec. 21 Twp. 23 R. 10-W

Well No. #1 Kreie "B" Farm \_\_\_\_\_

Cities Service Oil Company

(Peace Creek)


330 Ft. from N. Line

\_\_\_\_\_ Ft. from S. Line

330 Ft. from E. Line

\_\_\_\_\_ Ft. from W. Line

Elev. 1775

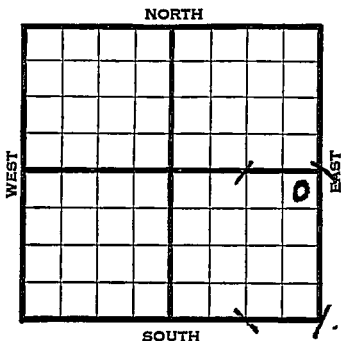

1941	REPORT
8/27	Rotary.
9/4	10" - 331' Drlg. 2370'
9/11	Drlg. 3735'
9/18	Topeka 2835' Lans. 3305'
	Miss. 3620' Kinderhook 3624'
	Viola 3793-97' T.D. 5" - 3794'
	700' oil in 1 hour.
9/24	Viola 3793'
	5" - 3794'
	T.D. 3797'
	Bomb potential 8000 bbls.
	Maximum 3000 bbls.
	42. Gravity
	<b>COMPLETED</b>

Map No. 47 Sec. 21 Twp. 23 R. 10W

Well No. 1 Kreie "C"

Cities Service Oil Company

~~FIRST REPORT~~ Contractor

NE SE


330 Ft. from N. Line

\_\_\_\_\_ Ft. from S. Line

330 Ft. from E. Line

\_\_\_\_\_ Ft. from W. Line

**SECTION PLAT**

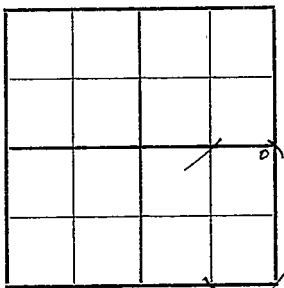

PEACE GREEK POOL

Location \_\_\_\_\_

Rig up \_\_\_\_\_

Drilling and Remarks:

Rotary

**RECORD**

Cased \_\_\_\_\_ in., \_\_\_\_\_ ft.

Sand \_\_\_\_\_

Gas \_\_\_\_\_

Oil \_\_\_\_\_

Total Depth \_\_\_\_\_

**PRODUCTION**

1st 24 hrs. Nat. \_\_\_\_\_

1st 24 hrs. after shot \_\_\_\_\_

Gas \_\_\_\_\_ Cu. Ft.

Dry Hole \_\_\_\_\_

Abandoned \_\_\_\_\_

Date

AUG 27 1941

19

S. J. LEWIS

Scout

Map No. K-47 Sec. 21 Twp. 23 R. 10WWell No. 1 Kreie "C"Cities Service Oil CompanyCOMPLETED Contractor

NE SE

330 Ft. from N. Line       Ft. from S. Line330 Ft. from E. Line       Ft. from W. Line

## SECTION FLAT

			o

PEACE CREEK POOL

Location \_\_\_\_\_

Rig up \_\_\_\_\_

Drilling and Remarks:

*Vista 3793**5" @ 3794**Bony 5000 ft**May 3000**42 @ 92*

## RECORD

Cased \_\_\_\_\_ in., \_\_\_\_\_ ft.

Sand \_\_\_\_\_

Gas \_\_\_\_\_

Oil \_\_\_\_\_

Total Depth 3792

## PRODUCTION

1st 24 hrs. Nat. \_\_\_\_\_

1st 24 hrs. after shot \_\_\_\_\_

Gas \_\_\_\_\_ Cu. Ft.

Dry Hole \_\_\_\_\_

Abandoned \_\_\_\_\_

Date

SEP 24 1941 19S. J. LEWIS Scout