

KANSAS
Reno

FORM 51 5M 10-41 PETROL

Section 21 Township 23 Range 10-W

Well No. #2 Kreie "B"

Company Cities Service oil

NORTH

				0			

SOUTH

WEST

EAST

10

Reno

Sec. 21 - Twp. 23 R. 10-W

Well No. #2 Kreele "B" Farm

Cities Service Oil Company

(Peace Creek)


990 Ft. from N. Line

Ft. from S. Line

Ft. from E. Line

330 Ft. from W. Line

Elev. 1788

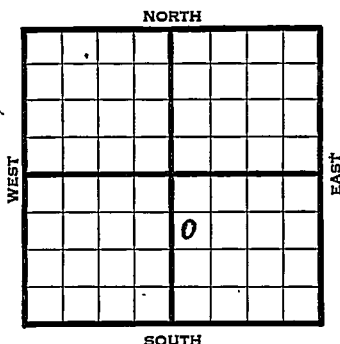[illegible]


Reno

KANSASMap No. 11-47 Sec. 21 Twp. 23 R. 10WWell No. 2 Kreie "B"Cities Service Oil CompanyFIRST REPORT Contractor

SW NW SE

990 Ft. from N. Line Ft. from S. Line Ft. from E. Line330 Ft. from W. Line

SECTION PLAT

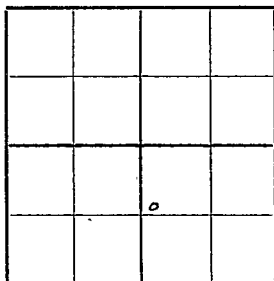

PEACE CREEK POOL

Location Rig up

Drilling and Remarks:

8" - 307'Waiting on
cement to set

RECORD

Cased in. ft.Sand Gas Oil Total Depth

PRODUCTION

1st 24 hrs. Nat. 1st 24 hrs. after shot Gas Cu. Ft.Dry Hole Abandoned

Date

NOV 12 1941S. J. LEWIS

Scout

Map No. 47 Sec. 21 Twp. 23 R. 10WWell No. 2 Kreie "B"Cities Service Oil CompanyCOMPLETED Contractor

SW NW SE

990 Ft. from N. Line Ft. from S. Line Ft. from E. Line330 Ft. from W. Line

SECTION PLAT

		6	

PEACE CREEK


RECORD

Cased in., ft.Sand Gas Oil Total Depth 8225

PRODUCTION

1st 24 hrs. Nat. 1st 24 hrs. after shot Gas Cu. Ft.Dry Hole Abandoned

Date

DEC 17 1941 19S. J. LEWIS Scout