

KANSAS

FORM 51 5M 10-41 PETROL

Reno

Section 21 Township 23 Range 10-W

Well No. 3 Kreie "B"

Company Cities Service Oil

NORTH Peace Creek Pool

15

WEST

EAST

SOUTH

0

Sec. 21 Twp. 23 R. 10-W

Well No. #3 Kreie "B" Farm

Cities Service Oil Company

(Peace Creek)


_____ Ft. from N. Line

990 Ft. from S. Line

_____ Ft. from E. Line

990 Ft. from W. Line

Elev. 1778

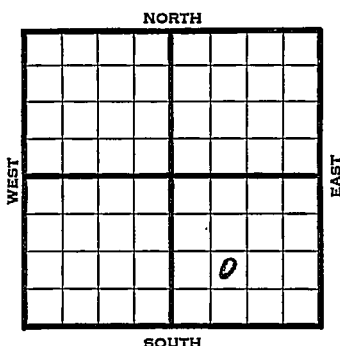

1941	REPORT
12/3	Surface hole.
12/11	8" @ 272 Drlg. 3220
12/13	Viola ³⁷⁷² 3772-75
	TD 5" @ 3775 RUST
12/24	Viola 3772' (Corrected)
	5" - 3773' T.D. 3781'
	Flow 23 oil per hour 5 hours.
12/24	
12/30	Viola 3772
	5" @ 3773
	TD 3781
	500 acid
	Bomb Potential 32550
	Maximum 3000
	42 Grav.
	COMPLETE

Reno

KANSAS

Map No. 47 Sec. 21 Twp. 23 R. 10WWell No. 3 Kreie "B"Cities Service Oil CompanyFIRST REPORT Contractor

NE SW SE

SECTION PLAT

_____ Ft. from N. Line

990 Ft. from S. Line

_____ Ft. from E. Line

990 Ft. from W. Line

PEACE CREEK POOL

Location _____

Rig up _____

Drilling and Remarks:

Surface Hole

RECORD

Cased _____ in., _____ ft.

Sand _____

Gas _____

Oil _____

Total Depth _____

PRODUCTION

1st 24 hrs. Nat. _____

1st 24 hrs. after shot _____

Gas _____ Cu. Ft.

Dry Hole _____

Abandoned _____

Date

DEC 3 1941 19S. J. LEWIS Scout

Map No. 47 Sec. 21 Twp. 23 R. 10W

Well No. 3 Kreie "B"

Cities Service Oil Company

COMPLETED Contractor

NE SW SE

SECTION PLAT

_____ Ft. from N. Line

990 Ft. from S. Line

_____ Ft. from E. Line

990 Ft. from W. Line

PEACE CREEK POOL

RECORD

Location _____

Cased _____ in., _____ ft.

Rig up _____

Sand _____

Drilling and Remarks:

Gas _____

Oil _____

Total Depth 3781

Vis loc 3772
5' @ 3773
500 acid
Born & Co 32530
M of 3000
420 gr

PRODUCTION

1st 24 hrs. Nat. _____

1st 24 hrs. after shot _____

Gas _____ Cu. Ft.

Dry Hole _____

Abandoned _____

Date

DEC 30 1941 19

S. J. LEWIS Scout