

KANSAS

FORM 51 5M 10-41 PETROL

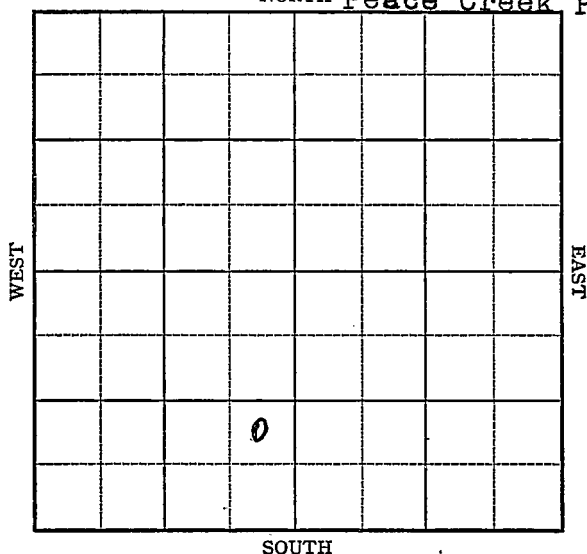
Reno

Section 21 Township 23 Range 10-W

Well No. 2 Kreie "D"

Company Cities Service Oil

NORTH Peace Creek Pool



Well No. #2 Kreis "D" Farm _____

Cities Service Oil

Company

(Peace Creek)

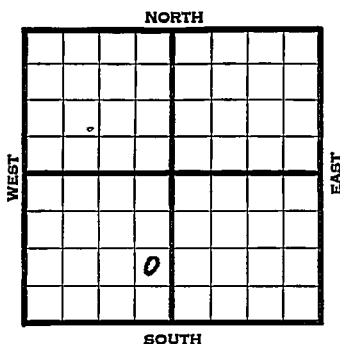
Ft. from N. Line

990 Ft. from S. Line

330 Ft. from E. Line

Ft. from W. Line

Elv. 1785

[illegible]

1942

2/4

Viola 3763'

5" - 3765'

T.D. 3777'

500 acid.

Bomb potential 40,984 bbls.

Maximum 3000 bbls.

42. Gravity.

COMPLETED

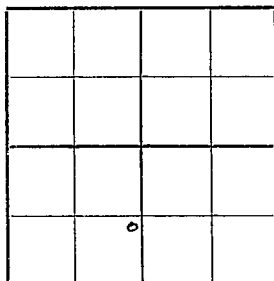
Reno

KANSAS

Map No. 47 Sec. 21 Twp. 23 R. 10WWell No. 2 Kreie "D"Cities Service Oil CompanyFIRST REPORT Contractor

NE SE SW

SECTION PLAT

 Ft. from N. Line990 Ft. from S. Line330 Ft. from E. Line Ft. from W. Line

PEACE CREEK POOL

Location Rig up

Drilling and Remarks:

Surface Hole

RECORD

Cased in., ft.Sand Gas Oil Total Depth

PRODUCTION

1st 24 hrs. Nat. 1st 24 hrs. after shot Gas Cu. Ft.Dry Hole Abandoned

Date

DEC 23 1941

19

S. J. LEWIS Scout

Map No. 47 Sec. 21 Twp. 23 R. 10WWell No. 2 Kreie "D"Cities Service Oil Company**COMPLETED**

Contractor

NE SE SW

SECTION PLAT

_____ Ft. from N. Line

990 Ft. from S. Line330 Ft. from E. Line

_____ Ft. from W. Line

PEACE CREEK POOL

Location _____

Rig up _____

Drilling and Remarks:

*Vila 3763**5" @ 3765**500 acid**Bomb & P.D. 40984**Max 3000**42 @ 37*

RECORD

Cased _____ in., _____ ft.

Sand _____

Gas _____

Oil _____

Total Depth 3227

PRODUCTION

1st 24 hrs. Nat. _____

1st 24 hrs. after shot _____

Gas _____ Cu. Ft.

Dry Hole _____

Abandoned _____

Date

FEB 4 1942 19

S. J. LEWIS

Scout