

KANSAS

FORM 51 5M 4-41 PETROL


Reno

Section 21 Township 23 Range 10-W

Well No. 3 Snowbarger

Company Republic Natural Gas

NORTH Peace River Pool

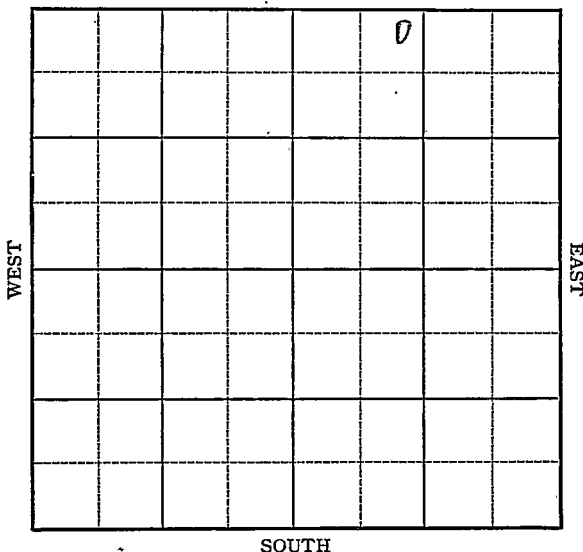

2

Sec. 21 Twp. 23 R. 10-W

Well No. #3 Snowbarger Farm

Republic Natural Gas Company


(Peace Creek)

330-990 Ft. from N. Line

_____ Ft. from S. Line

_____ Ft. from E. Line

990
530 Ft. from W. Line

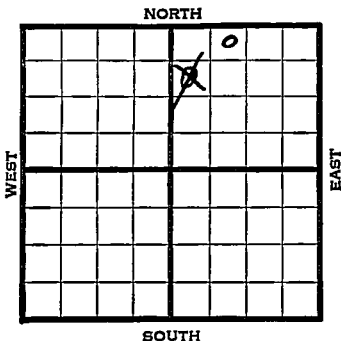

Elev. 1778

1941	REPORT
9/3	Rotary.
9/11	8" - 184' Drlg. 1746'
9/18	Drlg. 3340'
9/25	Viola 3761' T.D. 3766'
	5" - 3765' RUST.
	-
10/1	Viola 3761'
	5" - 3765'
	T.D. 3783'
	3500 acid.
	Potential 600 bbls., pump.
	42. Gravity
	COMPLETED

Map No. _____ Sec. 21 Twp. 23 R. 10W

Well No. 3 Snowbarger

Republic Natural Gas Company

FIRST REPORT Contractor _____

SECTION PLAT

SW NW NE

990 Ft. from N. Line

_____ Ft. from S. Line

_____ Ft. from E. Line

330 Ft. from W. Line

PEACE CREEK POOL

Location _____

Rig up _____

Drilling and Remarks:

Rotary

RECORD

Cased _____ in., _____ ft.

Sand _____

Gas _____

Oil _____

Total Depth _____

PRODUCTION

1st 24 hrs. Nat. _____

1st 24 hrs. after shot _____

Gas _____ Cu. Ft.

Dry Hole _____

Abandoned _____

Date

SEP 3 1941 19

S. J. LEWIS Scout

Reno

KANSAS
Map No. 47 Sec. 21 Twp. 23 R. 10WWell No. 3 Snowbarger

Republic Natural Gas Company

CORRECTION

Contractor

SECTION PLAT

NE NW NW

330 Ft. from N. Line

_____ Ft. from S. Line

_____ Ft. from E. Line

990 Ft. from W. Line

		α	

PEACE RIVER POOL

Location _____

Rig up _____

Drilling and Remarks:

Reported

SW NW NE

RECORD

Cased _____ in., _____ ft.

Sand _____

Gas _____

Oil _____

Total Depth _____

PRODUCTION

1st 24 hrs. Nat. _____

1st 24 hrs. after shot _____

Gas _____ Cu. Ft.

Dry Hole _____

Abandoned _____

Date

SEP 10 1941 19

S. J. LEWIS

Scout

Map No. K-47 Sec. 21 Twp. 23 R. 10WWell No. 3 SnowbargerRepublic Natural Gas CompanyCOMPLETED

Contractor

NE NW NE

990 Ft. from N. Line

_____ Ft. from S. Line

_____ Ft. from E. Line

990 Ft. from W. Line

SECTION PLAT

PEACE CREEK POOL

Location _____

Rig up _____

Drilling and Remarks:

*Vida 8761**5" @ 3765**3500 acid**Pump 600 Ps**42° Gr*

RECORD

Cased _____ in., _____ ft.

Sand _____

Gas _____

Oil _____

Total Depth 2783

PRODUCTION

1st 24 hrs. Nat. _____

1st 24 hrs. after shot _____

Gas _____ Cu. Ft.

Dry Hole _____

Abandoned _____

Date

OCT 1 1941 19

S. J. LEWIS Scout