


Section 21 Township 23 Range 10W

Well No. #3 Kreie "D"

Company Cities Service

Peace Creek Pool NORTH

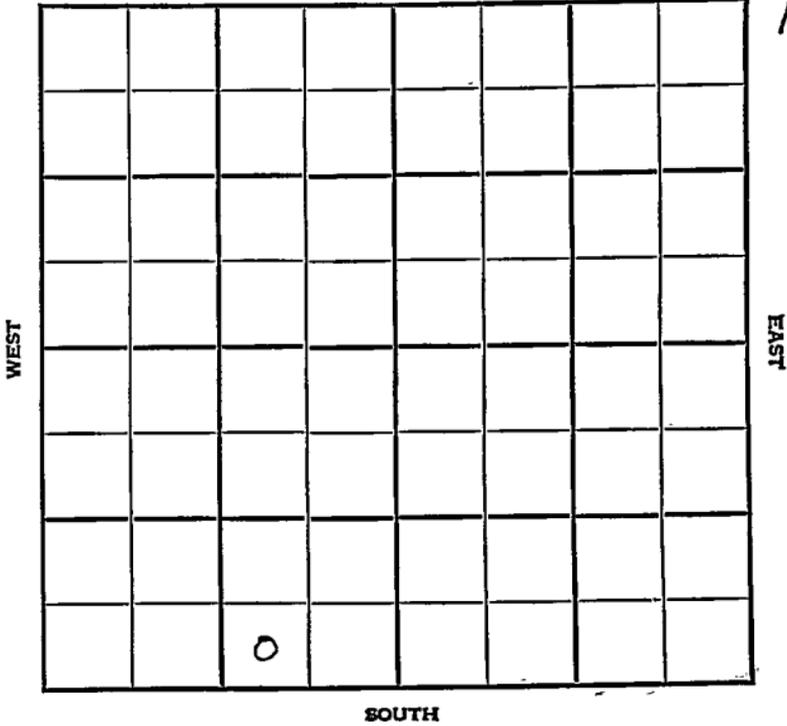

14

0

Reno

Sec. 21 KANSAS Twp. 23 R. 10W

Well No. #3 Kreie "D" Farm

Cities Service Company

Peace Creek Pool


\_\_\_\_\_ Ft. from N. Line

330' Ft. from S. Line

990' Ft. from E. Line

\_\_\_\_\_ Ft. from W. Line

SW S<sup>E</sup> SW

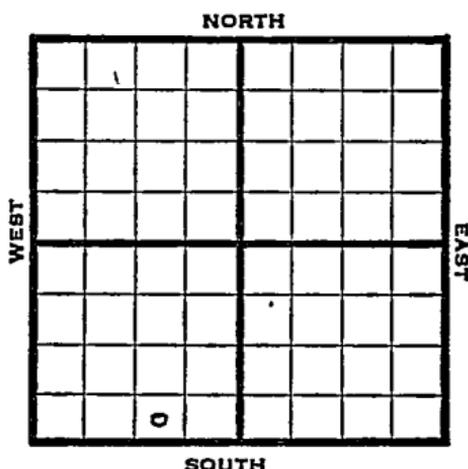

1948 Elev. 1780' REPORT

- 2/11 RUR
- 2/18 8" @ 296'  
Drlg 2566'
- 2/25 Viola 3763-67'  
TD 3767'  
5" @ 3765'  
RUST
- 3/3 SLM 3767'-62'  
Viola 3758'  
TD 3773'  
5" @ 3760'  
500 acid
- 3/10 Viola 3758'  
5" @ 3760'  
500 Acid  
Pump 145 Pot.  
Gr. 43°  
TD 3773'

**COMPLETED**

Kansas

Map No. \_\_\_\_\_ Sec. 21 Twp. 23 R. 10WWell No. 3 Kreie "D"

\_\_\_\_\_ Cities Service \_\_\_\_\_ Company

## FIRST REPORT

\_\_\_\_\_ Contractor

SW SE SW

## SECTION PLAT

\_\_\_\_\_ Ft. from N. Line

330 Ft. from S. Line990 Ft. from E. Line

\_\_\_\_\_ Ft. from W. Line

	o		

Reno County

Location \_\_\_\_\_

Rig up \_\_\_\_\_

Drilling and Remarks:

R U R

## RECORD

Cased \_\_\_\_\_ in., \_\_\_\_\_ ft.

Sand \_\_\_\_\_

Gas \_\_\_\_\_

Oil \_\_\_\_\_

Total Depth \_\_\_\_\_

## PRODUCTION

1st 24 hrs. Nat. \_\_\_\_\_

1st 24 hrs. after shot \_\_\_\_\_

Gas \_\_\_\_\_ Cu. Ft.

Dry Hole \_\_\_\_\_

Abandoned \_\_\_\_\_

Date

FEB 11 1948 19 \_\_\_\_\_S. J. LEWIS Scout

