

KANSAS

Reno


FORM 51 5M 4-41 PETROL

Section 21 Township 23 Range 10-W

Well No. 2 Snowbarger


Company Republic Natural Gas

Peace Creek Pool
NORTH

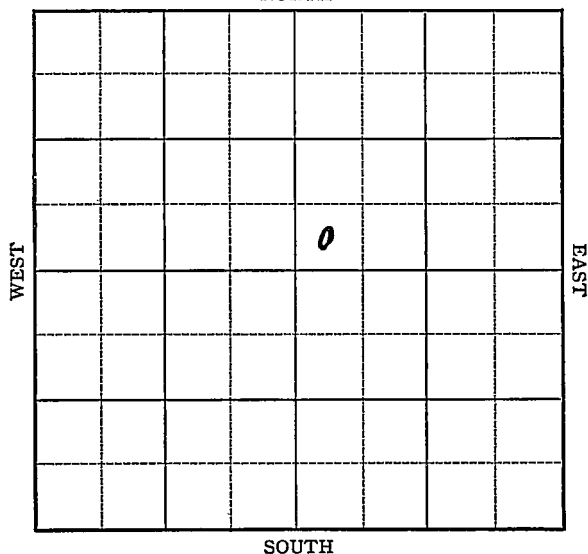

Sec. 21 Twp. 23 R. 10-WWell No. #2 Snowbarger FarmRepublic Natural Gas Company
(Peace Creek) Ft. from N. Line330 Ft. from S. Line Ft. from E. Line330 Ft. from W. Line

Elev. 1780

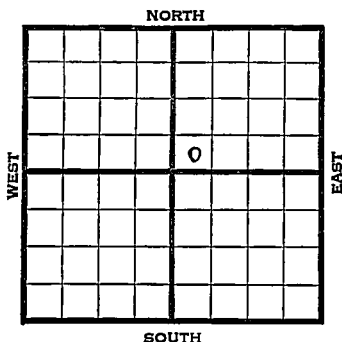

1941

REPORT

8/13 8" - 184 Anhy 455

Drlg. 1293

8/15 8" 184 Anhy 455 Dlg. 1293

8/21 Drlg. 2961'

8/28 SD 2961'

9/4 Skid rig. 35' east.

Rigging up.

9/11 8" - 182' Drlg. 1824'

9/18 Drlg. 3639'

9/25 Viola 3761' 5" - 3765'

T.D. 3785' RUST.

10/1 Viola 3761'

5" - 3765'

T.D. 3785'

3000 acid.

Bomb potential 16,452 bbls.

Maximum 3000 bbls.

42.5 Gravity

COMPLETED

Map No. 47 Sec. 21 Twp. 23 R. 10WWell No. 2 SnowbargerRepublic Natural Gas CompanyFIRST REPORT Contractor

SW NE

SECTION PLAT

		o	

_____ Ft. from N. Line

330 Ft. from S. Line

_____ Ft. from E. Line

330 Ft. from W. Line

PEACE CREEK POOL

Location _____

Rig up _____

Drilling and Remarks:

8" - 184 Anhy.Drilg. 1293 455

RECORD

Cased _____ in., _____ ft.

Sand _____

Gas _____

Oil _____

Total Depth _____

PRODUCTION

1st 24 hrs. Nat. _____

1st 24 hrs. after shot _____

Gas _____ Cu. Ft.

Dry Hole _____

Abandoned _____

Date

AUG 13 1941S. J. LEWIS Scout

Map No. K-47 Sec. 21 Twp. 23 R. 10WWell No. 2 SnowbargerRepublic Natural Gas CompanyCOMPLETED Contractor

SECTION PLAT

SW NE

		6	

Ft. from N. Line

330 Ft. from S. Line

Ft. from E. Line

330 Ft. from W. Line

PEACE CREEK POOL

Location

Rig up

Drilling and Remarks:

Vida 3761
5" @ 3765
3000 acid
Bomb 16452
Max 3000
425 Gr

RECORD

Cased _____ in., _____ ft.

Sand _____

Gas _____

Oil _____

Total Depth 3785

PRODUCTION

1st 24 hrs. Nat. _____

1st 24 hrs. after shot _____

Gas _____ Cu. Ft.

Dry Hole _____

Abandoned _____

Date

OCT 1 1941S. J. LEWIS Scout