

# KANSAS


FORM 51 5M 4-41 PETROL

Section 21 Township 23 Range 10-W

Well No. #2 Snowbarger

Company Simpson Oil et al

(Peace River)

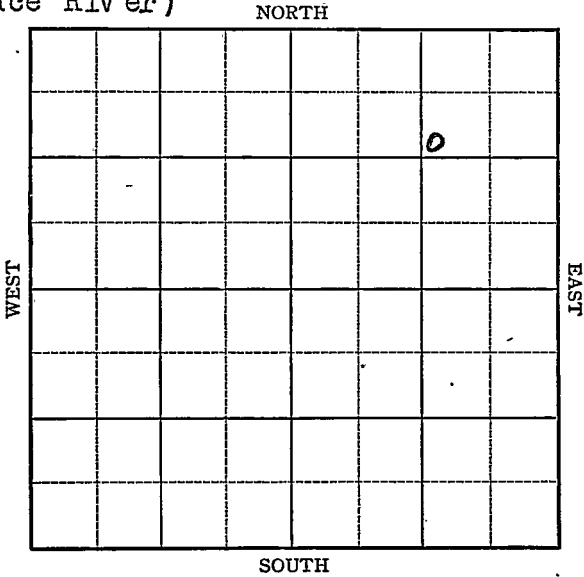



**KANSAS**

Map No. 47 Sec. 21 Twp. 23 R. 10W

Well No. 2 Snowbarger

Simpson Oil etal Company

FIRST REPORT Contractor

**SECTION PLAT**

SW NE NE

990 Ft. from N. Line

\_\_\_\_\_ Ft. from S. Line

990 Ft. from E. Line

\_\_\_\_\_ Ft. from W. Line

			o

PEACE RIVER POOL

**RECORD**

Location \_\_\_\_\_

Cased \_\_\_\_\_ in., \_\_\_\_\_ ft.

Rig up \_\_\_\_\_

Sand \_\_\_\_\_

Drilling and Remarks:

Gas \_\_\_\_\_

Oil \_\_\_\_\_

Derrick

Total Depth \_\_\_\_\_

**PRODUCTION**

1st 24 hrs. Nat. \_\_\_\_\_

1st 24 hrs. after shot \_\_\_\_\_

Gas \_\_\_\_\_ Cu. Ft.

Dry Hole \_\_\_\_\_

Abandoned \_\_\_\_\_

Date

AUG 6 1941 19

S. J. LEWIS Scout

Map No. 47 Sec. 21 Twp. 23 R. 10WWell No. 2 SnowbargerSimpson Oil etal CompanyCOMPLETED Contractor

SW NE NE

## SECTION PLAT

990 Ft. from N. Line

\_\_\_\_\_ Ft. from S. Line

990 Ft. from E. Line

\_\_\_\_\_ Ft. from W. Line

PEACE RIVER POOL


Location \_\_\_\_\_

Rig up \_\_\_\_\_

Drilling and Remarks:

*Vista 3768**5" C 3775**4000 acid**Bon 85687 P**Net 3000**42 1/2*

## RECORD

Cased \_\_\_\_\_ in., \_\_\_\_\_ ft.

Sand \_\_\_\_\_

Gas \_\_\_\_\_

Oil \_\_\_\_\_

Total Depth 2786

## PRODUCTION

1st 24 hrs. Nat. \_\_\_\_\_

1st 24 hrs. after shot \_\_\_\_\_

Gas \_\_\_\_\_ Cu. Ft.

Dry Hole \_\_\_\_\_

Abandoned \_\_\_\_\_

Date

SEP 3 1941 19

S. J. LEWIS Scout