

KANSAS


Stafford

Form 51-5M-7-39-Palace

Section 21 Township 23 Range 12W

Well No. #1 Bean

Company Shell

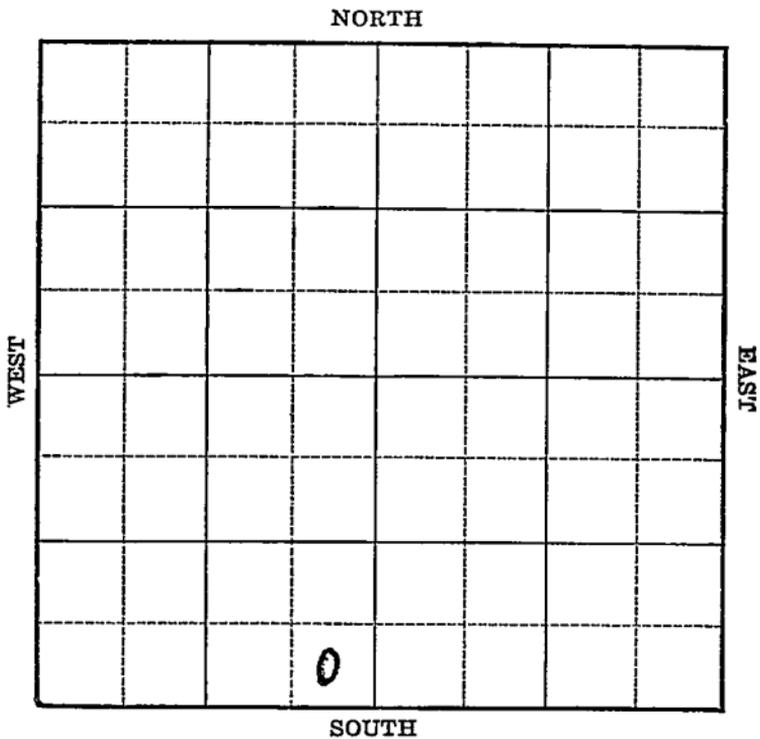

1940
9/4

Arb. 3839'

4" - 3840'

T.D. 3854'

2000 acid.

Echometer potential 18,100 bbls.

Cut 10%

Maximum 2700 bbls.

COMPLETED

Map No. 47 Sec. 21 Twp. 23 R. 12^W

Well No. 1 Bean

Shell Company

Contractor

FIRST REPORT

SECTION PLAT

SE SW

_____ Ft. from N. Line

330 Ft. from S. Line

330 Ft. from E. Line

_____ Ft. from W. Line

WILDCAT

Location X

Rig up _____

Drilling and Remarks: _____

RECORD

Cased _____ in., _____ ft.

Sand _____

Gas _____

Oil _____

Total Depth _____

PRODUCTION

1st 24 hrs. Nat. _____

1st 24 hrs. after shot _____

Gas _____ Cu: Ft.

Dry Hole _____

Abandoned _____

Date

JUL 17 1940 19

S I LEWIS Scout

