

Form 51-5M-7-40-Palace

Stafford

Section 21 Township 23 Range 12-W

Well No. #2 Bean

Company Shell

NORTH Stafford Pool

WEST

EAST

SOUTH

0

KANSAS

Stafford


Sec. 21 Twp. 23 R. 12-WWell No. #2 Bean FarmShell

Company

(Stafford)

 Ft. from N. Line991 Ft. from S. Line985 Ft. from E. Line Ft. from W. Line

Elev. 1860

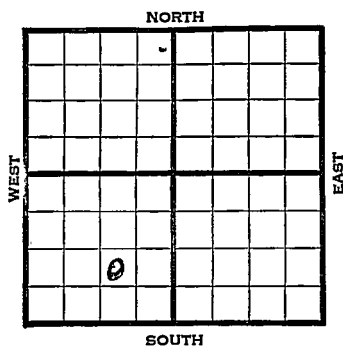

1940	REPORT
9/25	Location
10/3	8" - 270' Drlg. 1514'
10/10	Topeka 2945' Drlg. 3092'
10/17	Lans. 3400' Cong. 3692'
	Viola 3709' Drlg. 3795'
10/24	Simp. 3781' Arb. 3848'
	T.D. 3875' 4" - 3875' RUST.
10/31	" " " " "
11/7	12 shots 3860-63' Swab 101 oil & 108 water 9 hrs. P.B. to 3856
	35 shots 3842-52'
	Swab 161 bbls. fluid 6 hours, 52% water.
11/14	TD 3857' 35 shots 3848-57'
	500 acid. Swab 612 bbls. fluid 12 hours, cut 75% BS & W.
11/21	" " " " "
11/27	" " " " "
	OVER

1940

12/4

Arb. 3848'

4" - 3875'

T.D. 3875'

P.B. to 3857'

35 shots 3848-57'

500 acid.

Depthograph potential 261 oil &
2739 water. 41. Gravity

COMPLETED .

Map No. 47 Sec. 21 Twp. 23 R. 12WWell No. 2 BeanShell

Company

Contractor

FIRST REPORT

NW SE SW

 Ft. from N. Line991 Ft. from S. Line985 Ft. from E. Line Ft. from W. Line

STAFFORD POOL

SECTION PLAT

	o		

Location XRig up

Drilling and Remarks:

RECORD

Cased in., ft.Sand Gas Oil Total Depth

PRODUCTION

1st 24 hrs. Nat. 1st 24 hrs. after shot Gas Cu. Ft.Dry Hole Abandoned

Date

SEP 25 1940

19

S. J. LEWIS

Scout

Map No. 47 Sec. 21 Twp. 23 R. 12WWell No. 2 BeanShell

Company

Contractor

COMPLETED

NW SE SW

 Ft. from N. Line991 Ft. from S. Line985 Ft. from E. Line Ft. from W. Line

STAFFORD POOL

SECTION PLAT

	o		

Location Rig up

Drilling and Remarks:

*Ar 83848**4" @ 3875**PB 3857**35 Skrt to 3848-57**500 acid**Dry H₂O 261 oil**2739W. 412***RECORD**Cased in., ft.Sand Gas Oil Total Depth 3875**PRODUCTION**1st 24 hrs. Nat. 1st 24 hrs. after shot Gas Cu. Ft.Dry Hole Abandoned

Date

DEC 4 1940

19

S. J. LEWIS Scout