

Section 21 Township 23 Range 13WWell No. #1 FirebaughCompany Crown Oil

Wildcat

NORTH

WEST

EAST

							0

SOUTH

Stafford

Sec. 21 Twp. 23 R. 13W

Well No. #1 Firebaugh Farm

Crown Oil

Company

Wildcat


(Reserve Drlg, Cont^{NORTH})

 Ft. from N. Line

330' Ft. from S. Line

330' Ft. from E. Line

 Ft. from W. Line

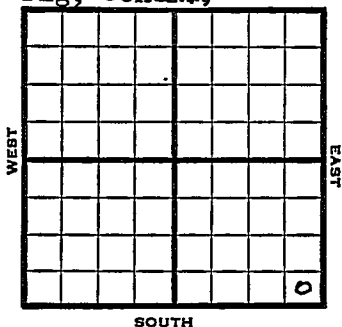

SE/C

SOUTH

1949

Elév. 1890'

R E P O R T

12/14

8" @ 326'

Drlg. 530'

12/28

Lans. 3502'

Viola 3906'

Simp 3947'

Art 4055'

TD 4085'

ABANDONED

Map No. _____ Sec. 21 Twp. 23 R. 13WWell No. 1 Firebaugh

Crown Oil _____ Company

Reserve Drlg. _____ Contractor

SE/C

FIRST REPORT
SECTION PLAT

_____ Ft. from N. Line

330 Ft. from S. Line330 Ft. from E. Line

_____ Ft. from W. Line

			0

Stafford County

Location _____

Rig up _____

Drilling and Remarks:

8" @ 326

drlg. 530

RECORD

Cased _____ in., _____ ft.

Sand _____

Gas _____

Oil _____

Total Depth _____

PRODUCTION

1st 24 hrs. Nat. _____

1st 24 hrs. after shot _____

Gas _____ Cu. Ft.

Dry Hole _____

Abandoned _____

Date

DEC 14 1949

19

S. J. LEWIS

Scout

Kansas

Wildcat

Map No. _____ Sec. 21 Twp. 23 R. 13WWell No. 1 Firebaugh

Crown Oil

Company

ABANDONED

Contractor

SE/C

E1.1890
SECTION PLAT

_____ Ft. from N. Line

330


Ft. from S. Line

330

Ft. from E. Line

_____ Ft. from W. Line

Stafford County

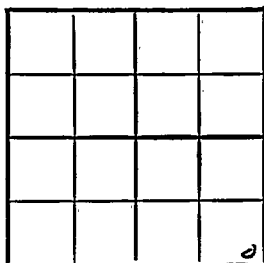

Location _____

Rig up _____

Drilling and Remarks:


RECORD

Cased _____ in., _____ ft.

Sand _____

Gas _____

Oil _____

Total Depth 4085

PRODUCTION

1st 24 hrs. Nat. _____

1st 24 hrs. after shot _____

Gas _____ Cu. Ft.

Dry Hole _____

Abandoned _____

Date

DEC 28 1949 19S. J. LEWIS

Scout