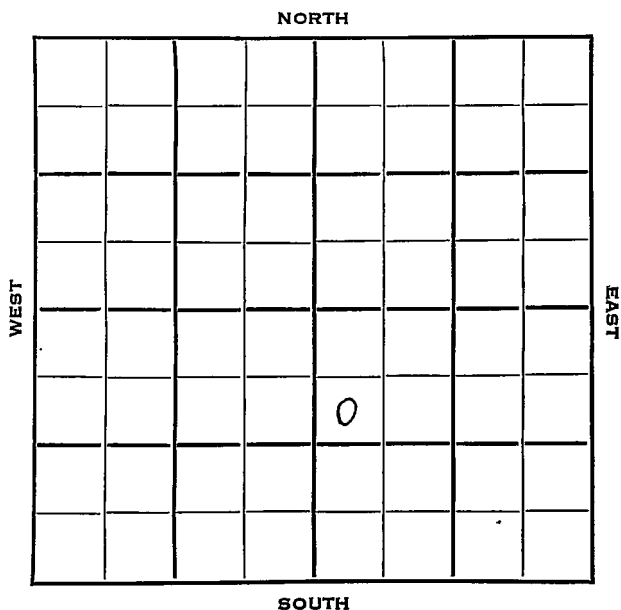


Section 21 Township 23 Range 14 WWell No. # 3 BirdsallCompany Greenland Drilling

Stafford KANSAS

SEC. 21	TWP. 23	R. 14 W ✓
----------------	----------------	------------------

WELL NO.

3 Birdsall FARM

COMPANY

Greenland Drlg.

CONTRACTOR

Greenland Drlg.


990 Ft. from N. Line

Ft. from S. Line

Ft. from E. Line

330 Ft. from W. Line

SW NW SE

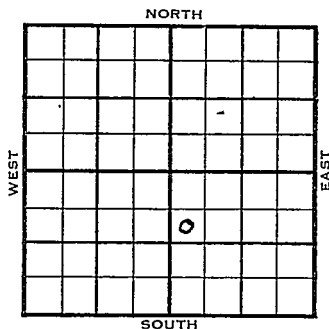

1953

ELEVATION

1952'

REPORT

12/16

Spud 12-12-53

8" @ 208

Drlg. 1310'

12/30

Spud 12-12-53 D & A TD 4040'

8" @ 208 Heeb 3433 Br. lime 3568

Lans. 3579 Viola 3946 Simp. 3981

DST 3981-4013 open 1 hr rec 120' gas,


40' GCM Arb. 4030'

TD 4040' D & A

ABANDONED

J. G. McGEHEE

County Stafford State Kansas
 Sec. 21 (Blk.) 23 (Sur.) 14W Map No.
 Operator Greenland Drlg.
 Well No. 3 Farm Birdsall
 Elev. 1952 Location SW NW SE

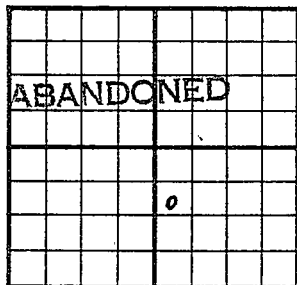

990 Ft. From N Line SE
330 Ft. From W Line Quarter

1st. Report

Completion DEC 30 1953

Remarks

Greenland Drlg. - Contr.

Spudding Date 12-12-53

Drlg. Data D & A TD 4040

8" @ 208 Heeb. 3433 Br. lime 3568

Lans. 3579 Viola 3946 Simp. 3981

DST 3981-4013 open 1 hr. Rec. 120' gas

40' gcm Arb. 4030 TD 4040

D & A

J. G. McGEHEE