


Section 21 Township 23 Range 34W

Well No. #1 Turentine

Company Champlin Ref.

Hugoton Pool

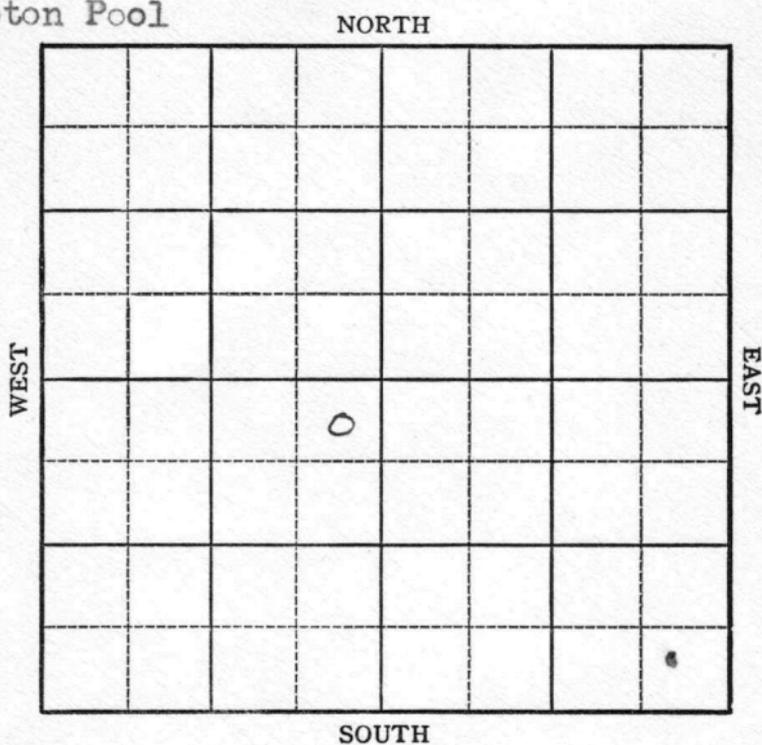

*need a completion*

Finney

KANSAS

Sec. 21 Twp. 23 R. 34W ✓

Well No. #1 Turentine Farm \_\_\_\_\_

Champlin Ref.

Company \_\_\_\_\_

Hugoton Pool


330' Ft. from N. Line

\_\_\_\_\_ Ft. from S. Line

330' Ft. from E. Line

\_\_\_\_\_ Ft. from W. Line

NE SW

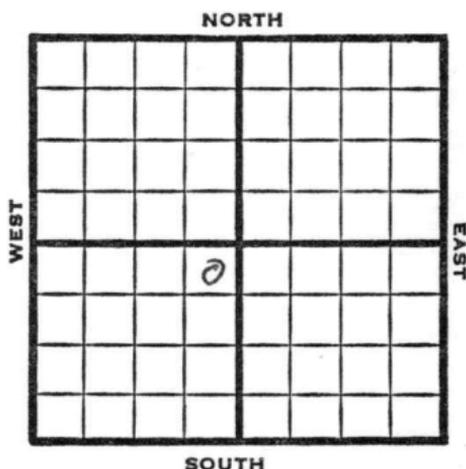

1949

Elv 2963

REPORT

12/14

Location

12/21

"

12/28

"

1950

7/26

9" @ 633

7" @ 2669

TD 2668

48/2619-27, 36/2608-14, 66/2595-2606

4500 acid

48/2552-60, 36/2543-49

4500 acid

108/2498-2516

72/2482-94

8000 acid

Her 2448

Krider 2478

Win 2542

Ft Riley 2594

Comp 671, 000 gas

Completed

**COMPLETED**

Map No. \_\_\_\_\_ Sec. 21 Twp. 23 R. 34W

Well No. 1 Turentine

Champlin Ref. Company

Contractor

NE SW


FIRST REPORT  
SECTION PLAT

330 Ft. from N. Line

\_\_\_\_\_ Ft. from S. Line

330 Ft. from E. Line

\_\_\_\_\_ Ft. from W. Line

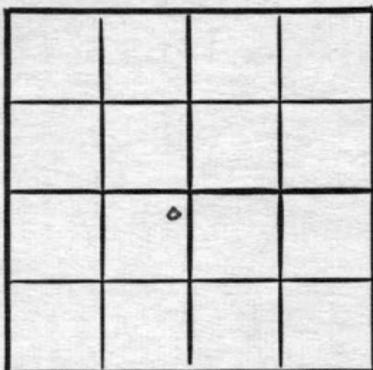

Finney County

Location X

Rig up \_\_\_\_\_

Drilling and Remarks:

RECORD

Cased \_\_\_\_\_ in., \_\_\_\_\_ ft.

Sand \_\_\_\_\_

Gas \_\_\_\_\_

Oil \_\_\_\_\_

Total Depth \_\_\_\_\_

PRODUCTION

1st 24 hrs. Nat. \_\_\_\_\_

1st 24 hrs. after shot \_\_\_\_\_

Gas \_\_\_\_\_ Cu. Ft.

Dry Hole \_\_\_\_\_

Abandoned \_\_\_\_\_

Date

DEC 14 1949

19

S. J. LEWIS

Scout

Map No. \_\_\_\_\_ Sec. 21 Twp. 23 R. 34W

Well No. 1 Turentine

Champlin Ref.

Company \_\_\_\_\_

Contractor \_\_\_\_\_

NE SW


E1. 2963  
SECTION PLAT

330 Ft. from N. Line

\_\_\_\_\_ Ft. from S. Line

330 Ft. from E. Line

\_\_\_\_\_ Ft. from W. Line

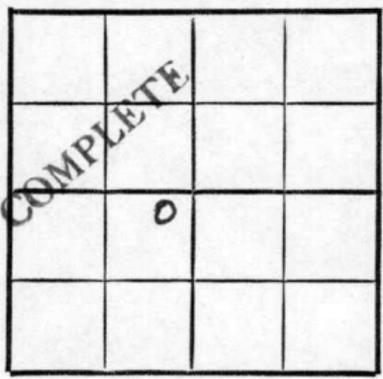

Finney County

Location \_\_\_\_\_

Rig up \_\_\_\_\_

Drilling and Remarks:

9" @ 633

7" @ 2668

TD 2668

48/ 2619-27

36/ 2608-14

66/ 2595-2606

4500 acid

RECORD

Cased \_\_\_\_\_ in., \_\_\_\_\_ ft.

Sand \_\_\_\_\_

Gas \_\_\_\_\_

Oil \_\_\_\_\_

Total Depth 2668

PRODUCTION

1st 24 hrs. Nat. \_\_\_\_\_

1st 24 hrs. after shot \_\_\_\_\_

Gas \_\_\_\_\_ Cu. Ft.

Dry Hole \_\_\_\_\_

Abandoned \_\_\_\_\_

Date

JUL 26 1950

19

J. E. TYRA

Scout

