


Section 21 Township 23 Range 35 W

Well No. # 1 Miller

Company Northern Pump

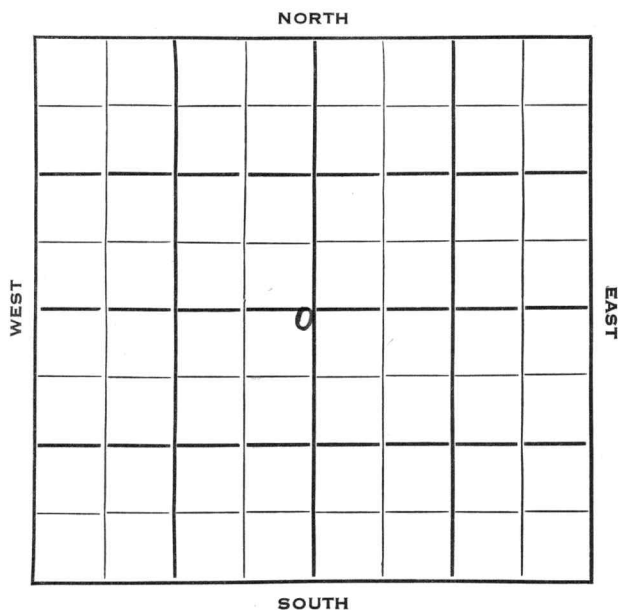

Sec. 21 Twp. 23 R. 35W

Well No. #1 Miller Farm

Northern Pump Company

Contractor

Hugoton Pool


150 Ft. from N. Line

Ft. from S. Line

150 Ft. from E. Line

Ft. from W. Line

NE SW

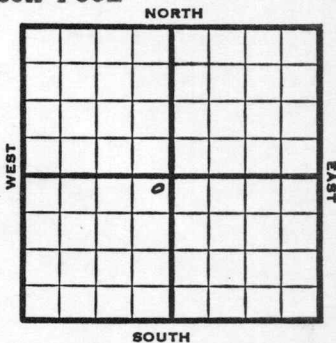

1953 Elev. 3023' REPORT

- 7/22 Location
- 8/12 "
- 8/19 10" @ 338'
Drlg 2495'
- 8/26 RTD 2640 Schl
7" @ 2635
Her 2522, Kr 2541, Win 2574, Tow 2633
- 9/2 CO 2625
18/ 2537-2618 sq. DD 2652'
- 9/9 Dol-frac. 1000 A Plug 2610
72/2576-88 48/2592-2600 Dol-frac
48/2526-34 72/2544-56 Dol-frac.
2000 A
- 9/16 Spud 8-12-53
Gas Well
TD 2652'
10" @ 338'
Her. 2522, Kri 2541, Win 2574, Tow 2633
TD 2640'
7" @ 2635'
CO to 2626
18/ 2537-2618 DD 2652 dol-frac
1000 A SP 2610 72/ 2576-88

OVER

1953

Information brought forward.

9/16 48/ 2592-2600 dol-frac 48/ 2526-34
72/ 2544-56 dol-crac 2000 A
Comp. 8 mcfgpd

COMPLETED

