


Section 21 Township 23 Range 37W

Well No. #1 Tate

Company Osborne

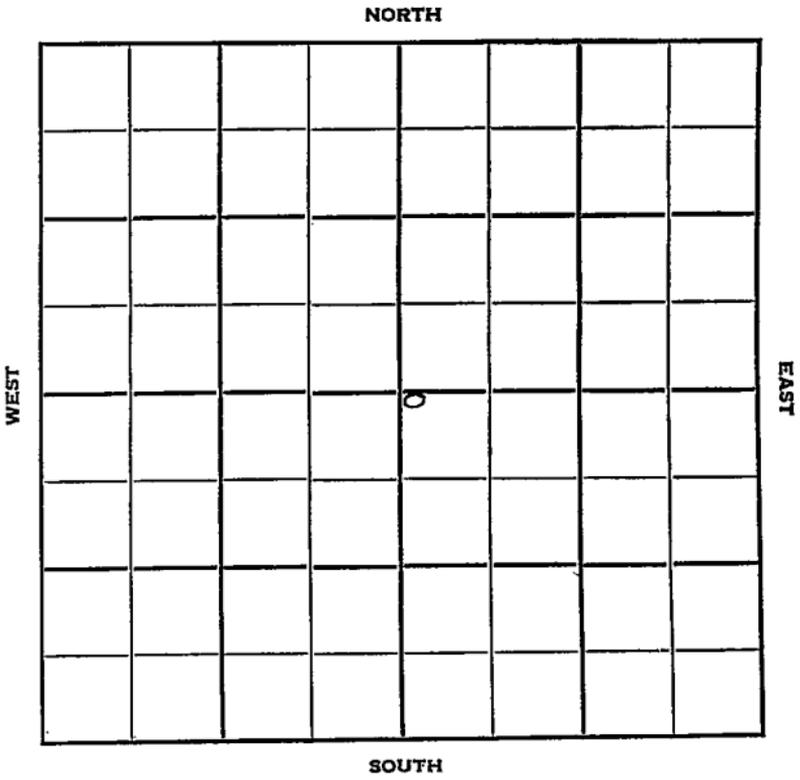

Kearny

KANSAS

Sec. 21 Twp. 23 R. 37 W

Well No. # 1 Tate Farm

Osborne Company

Contractor

Hugoton Pool


50 Ft. from N. Line

_____ Ft. from S. Line

_____ Ft. from E. Line

50 Ft. from W. Line

NW SE

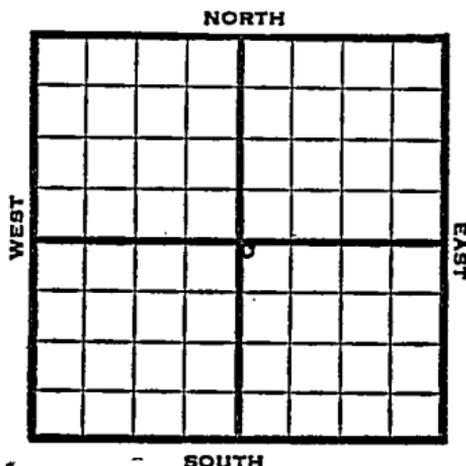

1951

Elev. 3290' REPORT

9/22

Spud 8-26-51
10" @ 450 TD 2545' 7" @ 2530'

11/21

Spud 8-26-51
Gas well TD 2732
10" @ 450 7" @ 2530 TD 2732
Her. 2537 Kri 2552 Win. 2586
Ft. Riley 2660 21000 A
Comp. 7,700,000 gas

COMPLETED

