


Kearny

KANSAS

SECTION 21 TOWNSHIP 23 RANGE 38 W

WELL NO. #1 Kurz Gas Unit "B"

COMPANY Stanolind

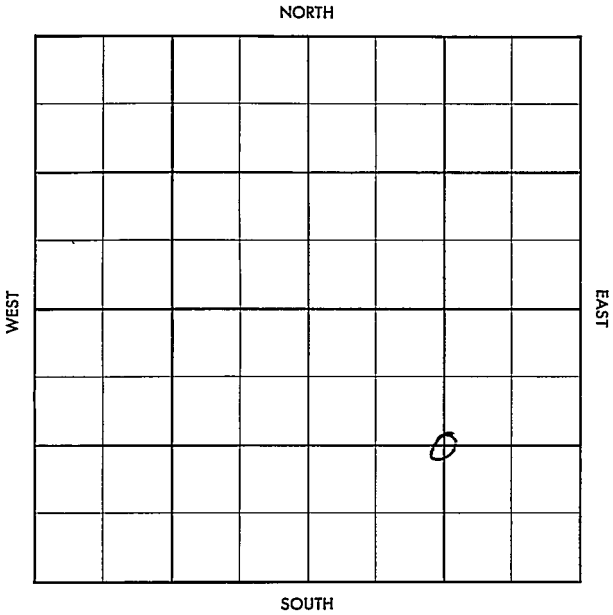

Kearny

KANSAS

SEC. 21	TWP. 23	R. 38W
------------	------------	-----------

WELL NO.

#1 Kurz Gas Unit "B"

FARM

COMPANY

Stanolind

CONTRACTOR

Noble

Hugoton


_____ Ft. from N. Line

_____ Ft. from S. Line

_____ Ft. from E. Line

_____ Ft. from W. Line

C SE/4

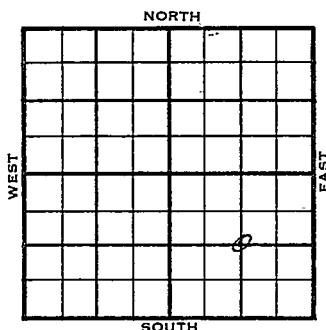

1955

ELEVATION

3369 RB, 3366 DF^{REPORT}

11-30

Location

1956

1-5

Comm. 12-10-55

8 5/8" @ 918/500

5 1/2" @ 2748/100

CO to 2744, 8/ 2736-38, 8/ 2726-28

20/ 2714-19, frac 164 mcfg,

PB 2696, 16/ 2690-94, 24/2682-88,

28/ 2673-80, 130 mcfg, frac, 760 mcfg

PB 2656, 32/ 2624-32, 20/ 2635-40

32/ 2646-54, frac

CO to 2726, 980 mcfg.

Comp. 1,261 mcfgpd.

Herr-Nri 2624

Winf. 2673

Tow. 2735

TD 2750'

COMPLETED

3369 RB

3366 DF

38W

County Kearny

Elev.

Sec. 21 Twp. 23

Rge.

Company StanolindFarm Name Kurz Gas Unit "B"No. 1

TOPS

DEPTH

LOG

DATUM

Loc. in Sec.

Anh.

Tp.

H.

Tr.

Dg.

Bl.

L.

K.C.

B.K.C.

Ce.

C.

M.

M.

K.

Mz.

Ma.

V.

S.

S.

A.

R.

Pe.

G.

T.D.

C SE 1/4

Geol.

Contr.

Noble

Pool

Hugoton

FIRST REPORT

NOV 30 '55

Date Comm.

Location

34

3369 RB

County Kearny Elev. 3366 DFSec. 21 Twp. 23 Rge. 38WCompany StanolindFarm Name Kurz Gas Unit "B" No. 1

TOPS	DEPTH	LOG	DATUM
Anb.			
Tr.			
H. <u>Horn-Kri</u>	<u>21024</u>		
Tr. <u>Nan</u>	<u>21073</u>		
Dg. <u>Truf</u>	<u>2735</u>		
Bl.			
L.			
K.C.			
B.K.C.			
Ce.			
C.			
M.			
M.			
K.			
Mz.			
Ma.			
V.			
S.			
S.			
A.			
R.			
Pe.			
G.			
T.D.	<u>2750</u>		

Loc. in Sec.

C SE/4

Geol.

Contr.

Noble

Pool

Hugoton

COMPLETE

Date Comm. 12-10-55 JAN 5 1956

8 5/8" @ 918/500 5 1/2" @ 2748/1000

CO to 2744 8/ 2736-38 8/ 2726-28

20/ 2714-19 frac 164 mcfg PB 2696

16/ 2690-94 24/ 2682-88 28/ 2673-80

130 mcfg frac 760 mcfg PB 2656

32/ 2624-32 20/ 2635-40 32/ 2646-54

frac CO to 2726 980 mcfg

Comp. 1,261 mcfcpd