

STATE CORPORATION COMMISSION OF KANSAS
OIL & GAS CONSERVATION DIVISION
WELL COMPLETION OR RECOMPLETION FORM
ACO-1 WELL HISTORY

DESCRIPTION OF WELL AND LEASE

Operator: license # 9220
name Benson-McCown & Company
address P.O. Box 7805
3915 Bell
City/State/Zip Amarillo, Texas 79114-7805

Operator Contact Person Carl H. Benson
Phone (806) 353-7429

Contractor: license # 5836
name Big Three Drilling Inc.

Wellsite Geologist Gordon Prather
Phone (806) 374-5881

PURCHASER

Indicate Type of Completion

☒ New Well ☐ Re-Entry ☐ Workover

☐ Oil ☐ SWD ☐ Temp Abd
☐ Gas ☐ Inj ☐ Delayed Comp.
☒ Dry ☐ Other (Core, Water Supply etc.)

If OWWO: old well info as follows:

Operator
Well Name
Comp. Date Old Total Depth

RECEIVED
STATE CORPORATION COMMISSION
OCT 22 1984

CONSERVATION DIVISION
Wichita, Kansas

WELL HISTORY

Drilling Method: ☒ Mud Rotary ☐ Air Rotary ☐ Cable

9/6/84 9/24/84 9/24/84
Start Date Date Reached TD Completion Date

4530'
Total Depth PBTD

Amount of Surface Pipe Set and Cemented at 469 feet

Multiple Stage Cementing Collar Used? ☐ Yes ☒ No

If Yes, Show Depth Set feet

If alternate 2 completion, cement circulated
from feet depth to w/ SX cmt

Wire line log received
Drillers time log received

API NO. 15 - 083-21157

County Hodgeman

C NE SW Sec 6 Twp 23S Rge 22 East
(location) West

1980 Ft North from Southeast Corner of Section
3300 Ft West from Southeast Corner of Section
(Note: locate well in section plat below)


Lease Name Housman Well# 1

Field Name Wildcat

Producing Formation

Elevation: Ground 2231 KB 2236

Section Plat

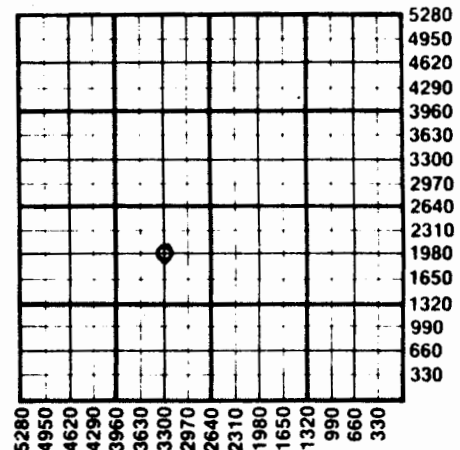

WATER SUPPLY INFORMATION

Source of Water: Furnished by contractor

Division of Water Resources Permit #

☐ Groundwater Ft North From Southeast Corner and
(Well) Ft West From Southeast Corner of

Sec Twp Rge ☐ East ☐ West

☐ Surface Water Ft North From Southeast Corner and
(Stream, Pond etc.) Ft West From Southeast Corner

Sec Twp Rge ☐ East ☐ West

☐ Other (explain)
(purchased from city, R.W.D.#)

Disposition of Produced Water: ☐ Disposal
☐ Repressuring

Docket #

INSTRUCTIONS: This form shall be completed in duplicate and filed with the Kansas Corporation Commission, 200 Colorado Derby Building, Wichita, Kansas 67202, within 90 days after completion or recompletion of any well. Rules 82-3-130 and 82-3-107 apply.

Information on side two of this form will be held confidential for a period of 12 months if requested in writing and submitted with the form. See rule 82-3-107 for confidentiality in excess of 12 months.

One copy of all wireline logs and drillers time log shall be attached with this form. Submit CP-4 form with all plugged wells. Submit CP-111 form with all temporarily abandoned wells.

SIDE TWO

Operator Name Benson-McCown & Company Lease Name Housman Well# 1 SEC 6 TWP. 23S RGE. 22W ☐ We ☒

WELL LOG

INSTRUCTIONS: Show important tops and base of formations penetrated. Detail all cores. Report all drill stem tests giving interval tested, time tool open and closed, flowing and shut-in pressures, whether shut-in pressure reached static level, hydrostatic pressures, bottom hole temperature, fluid recovery, and flow rates if gas to surface during test. Attach extra sheet if more space is needed. Attach copy of log.

Drill Stem Tests Taken

☒ Yes☐ No

Samples Sent to Geological Survey

☒ Yes☐ No

Cores Taken

☐ Yes☒ No

Formation Description

☒ Log☐ Sample

Name

Top

Bottom

DST #1 4460' - 80' open 30'.
Weak blow died 9'.
Shut-in 60', Test failed.

DST #2 4460' - 80'. Open 15' died.
Shut-in 60' - Test failed.
IFP 42 PSI
ISI BHP 1080 PSI

Show: 4480' good stn, free oil, good odor

Stone Corral
Heebner
Kansas City
Marmaton
Ft. Scott
Mississippian

1367
3784
3845
4166
4388
4468

CASING RECORD

☐ new☒ used

Report all strings set - conductor, surface, intermediate, production, etc.

Purpose of string	size hole drilled	size casing set (in O.D.)	weight lbs/ft.	setting depth	type of cement	# sacks used	type and percent additives
Surface	12. 1/4"	9. 5/8"	40. lbs	469	Pozmis.	275	2% CaCl., Gel. 1

PERFORATION RECORD

Acid, Fracture, Shot, Cement Squeeze Record

shots per foot	specify footage of each interval perforated	(amount and kind of material used)	Depth