

Incl 8

STATE CORPORATION COMMISSION OF KANSAS
OIL & GAS CONSERVATION DIVISION
WELL COMPLETION OR RECOMPLETION FORM
ACO-1 WELL HISTORY
DESCRIPTION OF WELL AND LEASE

Operator: License # 8728
Name Rockhound Resources, Inc.
Address P.O. Box 1010
City/State/Zip Great Bend, Ks. 67530.

Purchaser.....

Operator Contact Person Rod Tremblay
Phone 316-792-8251

Contractor: License # 4087
Name Williamson Drilling, Inc.

Wellsite Geologist Rod Tremblay
Phone 316-792-8251

Designate Type of Completion
 New Well Re-Entry Workover
 Oil SWD Temp Abd
 Gas Inj Delayed Comp.
 Dry Other (Core, Water Supply etc.)
If **OWWO**: old well info as follows:

Operator
Well Name
Comp. Date Old Total Depth.....

WELL HISTORY

Drilling Method:
 Mud Rotary Air Rotary Cable

~~3-12-86~~ ~~3-26-86~~ ~~3-26-86~~
Spud Date Date Reached TD Completion Date
4468'
Total Depth PBTD

Amount of Surface Pipe Set and Cemented at 1062 feet
Multiple Stage Cementing Collar Used? Yes No
If yes, show depth set.....feet
If alternate 2 completion, cement circulated
from.....feet depth to.....w/.....SX cmt
Cement Company Name Sun Cementing Inc.
* Invoice #


API NO. 15-083-21,248
County Hodgeman
C NW SW Sec. 10 Twp. 23 Rge. 22 East
..... West
1980 Ft North from Southeast Corner of Section
4620 Ft West from Southeast Corner of Section
(Note: Locate well in section plat below)
Lease Name Lupfer Well #. 1

Field Name.....

Producing Formation.....

Elevation: Ground 2200' KB 2205'

Section Plat

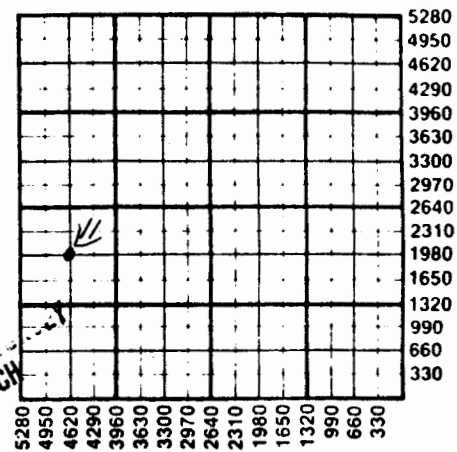

APR 11 1986

KANSAS GEOLOGICAL SURVEY
WICHITA BRANCH

WATER SUPPLY INFORMATION

Disposition of Produced Water: Disposal
Docket # Repressuring

Questions on this portion of the ACO-1 call:

Water Resources Board (913) 296-3717

Source of Water:
Division of Water Resources Permit # Irrigation Well

Groundwater 100 Ft North from Southeast Corner
(Well) 2500 Ft West from Southeast Corner of
Sec 3 Twp 23 Rge 22 East West

Surface Water.....Ft North from Southeast Corner
(Stream, pond etc).....Ft West from Southeast Corner
Sec Twp Rge East West

Other (explain).....
(purchased from city, R.W.D. #)

INSTRUCTIONS: This form shall be completed in duplicate and filed with the Kansas Corporation Commission, 200 Colorado Derby Building, Wichita, Kansas 67202, within 90 days after completion or recompletion of any well. Rule 82-3-130 and 82-3-107 apply.
Information on side two of this form will be held confidential for a period of 12 months if requested in writing and submitted with the form. See rule 82-3-107 for confidentiality in excess of 12 months.
One copy of all wireline logs and drillers time log shall be attached with this form. Submit CP-4 form with all plugged wells. Submit CP-111 form with all temporarily abandoned wells.

SIDE TWO

Operator Name Redhound Resources, Inc. Lease Name Lupfer Well # 1

C NW SW
 Sec. 10 Twp. 23 Rge. 22 East West County Hodgeman

WELL LOG

INSTRUCTIONS: Show important tops and base of formations penetrated. Detail all cores. Report all drill stem tests giving interval tested, time tool open and closed, flowing and shut-in pressures, whether shut-in pressure reached static level, hydrostatic pressures, bottom hole temperature, fluid recovery, and flow rates if gas to surface during test. Attach extra sheet if more space is needed. Attach copy of log.

Drill Stem Tests Taken Yes No
 Samples Sent to Geological Survey Yes No
 Cores Taken Yes No

Formation Description
 Log Sample

DST #1
 4399-4468 Mississippi
 Open: IF 45"
 FF 45"
 Blow: Strong
 Rec: 2700' Salt Water
 Pres: ISIP 1397 (45")
 FSIP 1397 (45")
 IFP 293-883
 FFP 984-1237'
 HSH 2205-2190

Name	Top	Bottom
Heebner	3773	-1568
Toronto	3787	-1582
Lansing	3842	-1637
Base K.C.	4203	-1998
Marmaton	4212	-2007
Pawnee	4280	-2075
Fort Scott	4360	-2155
Cherokee	4385	-2180
Mississippi	4439	-2234
R.T.D.	4468	-2263

CASING RECORD <input checked="" type="checkbox"/> New <input type="checkbox"/> Used							
Report all strings set-conductor, surface, intermediate, production, etc.							
Purpose of String	Size Hole Drilled	Size Casing Set (in O.D.)	Weight Lbs/Ft.	Setting Depth	Type of Cement	#Sacks Used	Type and Percent Additives
Surface	12 1/4	8 5/8	23	1062	Lite	200	3% CC
					60/10 Pgw	200	2% Gel, 3% CC
PERFORATION RECORD				Acid, Fracture, Shot, Cement Squeeze Record			
Shots Per Foot	Specify Footage of Each Interval Perforated			(Amount and Kind of Material Used)			Depth
.....
.....
.....
.....
TUBING RECORD				Liner Run <input type="checkbox"/> Yes <input type="checkbox"/> No			
	Size	Set At	Packer at				
Date of First Production				Producing Method			

10-23-22W^P

WILLIAMSON DRILLING, INC.

5501 NAVAJO

GREAT BEND, KANSAS 67530

(316) 793-8229

DRILLERS' WELL LOG

Tard

DATE COMMENCED: March 19, 1986
DATE COMPLETED: March 26, 1986

Rockhound Resources, Inc.
Lupfer #1
C NW SW
Sec. 10, T23S, R22W
Hodgeman County, Ks.

ELEVATION:

Surface Pipe: Ran 25 Jts. New 23#
8 5/8" Casing. Set @ 1060'. Cemented
w/200 sks. Lite, 200 sks. 60/40 Poz,
2% Gel, 3% CC.

Production Casing: None

- 0 - 900' Surface Soil, Sand, Shale,
Clay
- 900 - 1318' Redbed
- 1318 - 1352' Anhydrite
- 1352 - 4404' Lime & Shale
- 4404 - 4439' Lime
- 4439 - 4450' Chert
- 4450 - 4468' Dolomite
- 4468' R.T.D.

APR 11 1986

KANSAS GEOLOGICAL SURVEY
WICHTA BARRON

A F F I D A V I T

STATE OF KANSAS
COUNTY OF BARTON ss.

Terry L. Williamson of lawful age, does swear and state that the facts and statements herein are true and correct to the best of his knowledge.