

Well No. 1 - Camp Farm

NORTH

							0

SOUTH

Location.....

Drilling Remarks

Rig Up.....

Drilling Remarks

RECORD

Cased.....in.....ft.

Sand.....

Gas.....

Oil_____

Total Depth.....

PRODUCTION

1st 24 hrs. Nat.....

1st 24 hrs. after shot.....

Gas.....cu. ft.

Dry Hole.....

Abandoned.....

Map No. KANSAS Sec. 22 Twp. 23 R. 1 W

Well No. 1- Trupp Farm


Jolly - Ogg Pet. et al Company

 Ft. from N. Line

330 Ft. from S. Line

330 Ft. from E. Line

 Ft. from W. Line

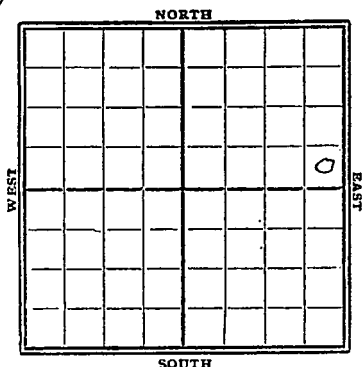

1929

Date	REPORT
2/27	Sellar
3/16	Rig
3/13	Rign up.
3/20	
3/27	Drly 580'
4/13	" 1285'
4/10	T.D. 1395, log UK logs
4/17	UIR 12 1/2" 1535 TD.
4/24	Drly 1550'
5/1	" 2095'
5/8	" 2465'
5/15	" 2620'
5/22	" 2740'
5/29	UK 8"-2945'
6/5	well 3060 8"-3000
6/12	log tools 3220
6/19	S.D. 3220
6/26	—
7/2	—
7/10	—
7/17	—
7/24	—

MAP No. 1045 SEC. 22 TWP. 23 R. 1W

WELL No. 1 Huffer

Jolly Ogg. Pet. & Co. COMPANY

CONTRACTOR

SECTION PLAT

_____ Ft. FROM N. LINE

830 Ft. FROM S. LINE

830 Ft. FROM E. LINE

_____ Ft. FROM W. LINE

FIRST REPORTS

LOCATION _____

RIG UP _____

DRILLING AND REMARKS:

C & Har

RECORD

CASED _____ IN. _____ FT.

SAND _____

GAS _____

OIL _____

TOTAL DEPTH _____

PRODUCTION

1ST 24 HRS. NAT. _____

1ST 24' HRS. AFTER SHOT _____

GAS _____ CU. FT.

DRY HOLE _____

ABANDONED _____

DATE

FEB 27 1929

192

S. J. L. MTS

SCOUT

Harvey

Map No. KANSAS Sec. 22 Twp. 23 R. 1WWell No. 39 HuffJolly Ogg & Co. Company

Contractor

SECTION PLAT

			a

Ft. from N. Line

320 Ft. from S. Line320 Ft. from E. Line

Ft. from W. Line

ABANDONED

Location

Rig up

Drilling and Remarks:

RECORD

Cased.....in.,ft.

Sand.....

Gas.....

Oil.....

Total Depth...3220.....

PRODUCTION

1st 24 hrs. Nat.....

1st 24 hrs. after shot.....

Gas.....Cu. Ft.

Dry Hole.....

Abandoned.....

Date

DEC 23 1929

192

S. J. LEWIS

Scout

7/31 - —
8/7 - SD. 3220'
8/14 —
8/21 —
~~8/28~~ —
9/4 —
9/11 —
9/18 —
9/25 —
10/2 —
10/9 —
10/16 —
10/23 —
10/30 —
11/6 —
11/13 —
11/20 —
11/27 —
12/4 —
12/11 —
12/18 —

12/23 - TD. 3220'

Dry & Abandon