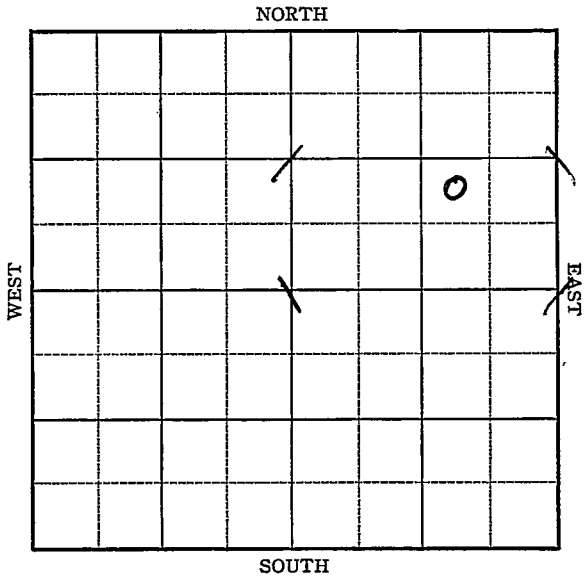


Harvey


Section 22 Township 23 Range 2-WWell No. 1 Brown Bros.Company National Refining

KANSAS

Harvey

Sec. 22 Twp. 23 R. 2-17Well No. #1 Brown Bros. Farm
National Refining Company Ft. from N. Line990 Ft. from S. Line990 Ft. from E. Line Ft. from W. Line

Elev. 1396

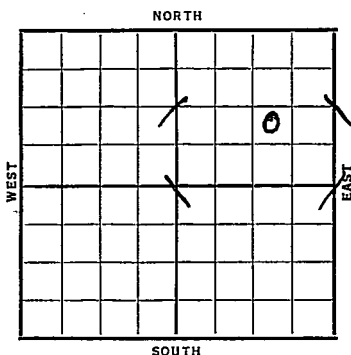

Date	REPORT
1937	
11/10	Location
11/19	C. R.
11/26	"
12/3	"
12/10	"
12/17	24" @ 30'. 20" @ 67'. Drlg. 305'.
12/24	15" @ 643'. Drlg. 915'.
12/31	12" @ 1485'. Drlg. 1570'.
1938	
1/7	Drlg. 2255'.
1/14	10" @ 2490'. Drlg. 2492'.
1/20	K.C. 2330' T.D. 2575' Pulling 10"
1/28	10" - 2575' 8" - 2785' Cleaning out.
2/4	Chat 2974' H.F.W. 3000-10 T.D. 3030' S.D. Repairs
2/11	8" @ 3096'. Drlg. 3100'.
	OVER

1938

2/18

Misner 3274'.

Hunton 3288'.

H.F.W. 3290-3300'.

Sylvan 3345'. Drlg. 3400'.

1938

2/23

Viola 3384'.

Simp. 3432'.

Arb. 3501'.

T.D. 3515'.

ABANDONED

Harvey KANSAS

Map No. 39 Sec. 22 Twp. 23 R. 2WWell No. 1 Brown Bros.

National Refining Company

Contractor

FIRST REPORT

NW SE NE


Ft. from N. Line

990 Ft. from S. Line

990 Ft. from E. Line

Ft. from W. Line

SECTION PLAT

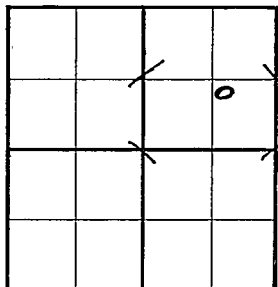Location X

Rig up

Drilling and Remarks:

RECORD

Cased _____ in., _____ ft.

Sand _____

Gas _____

Oil _____

Total Depth _____

PRODUCTION

1st 24 hrs. Nat. _____

1st 24 hrs. after shot _____

Gas _____ Cu. Ft.

Dry Hole _____

Abandoned _____

Date

NOV 10 1927 19

H. D. Hatfield Scout

Harvey

KANSAS

Map No. 39 Sec. 22 Twp. 23 R. 2WWell No. 1 Brown Bros.

National Refining

Company

Contractor

ABANDONED

NW SE NE

Ft. from N. Line

990 Ft. from S. Line990 Ft. from E. Line

Ft. from W. Line

SECTION PLAT

			0

Location _____

Rig up _____

Drilling and Remarks:

Viola 3384
Simp 3432
Arb 3501
TD 3515

D & A

RECORD

Cased _____ in., _____ ft.

Sand _____

Gas _____

Oil _____

Total Depth 3515

PRODUCTION

1st 24 hrs. Nat. _____

1st 24 hrs. after shot _____

Gas _____ Cu. Ft.

Dry Hole _____

Abandoned _____

Date

FEB 23 1938

19

H. D. Hatfield

Scout