

KANSAS

Reno

FORM 51 5M 10-41 PETROL

Section 22 Township 23 Range 10-W

Well No. 3 Snowbarger

Company Cities service oil

NORTH Peace Creek Pool

	0							

4

WEST

EAST

SOUTH

KANSAS

Reno

Sec. 22 Twp. 23 R. 10-W

Well No. #3 Snowbarger Farm

Cities Service Oil Company

(Peace Creek)


330 Ft. from N. Line

_____ Ft. from S. Line

_____ Ft. from E. Line

990 Ft. from W. Line

Elev. 1775

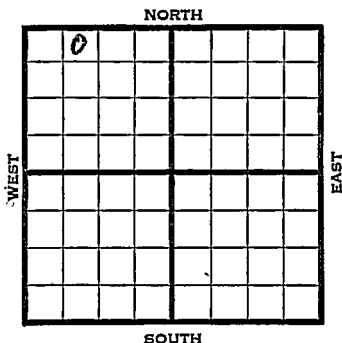

1941	REPORT
12/3	Moving in rotary.
12/11	8" @ 287 Drlg. 2740
12/18	La. s. 3316
	Viola 3772-85 TD 5" @ 3782
	RUST
12/24	"
12/31	T.D. 3786'
1942	
1/7	Viola 3782'
	5" - 3782'
	T.D. 3786'
	5000 acid.
	Bomb potential 19,134 bbls.
	Maximum 3000 bbls.
	42. Gravity
	COMPLETED

Reno

KANSAS

Map No. 47 Sec. 22 Twp. 23 R. 10WWell No. 3 SnowbargerCities Service Oil CompanyFIRST REPORT Contractor

NE NW NW

SECTION PLAT

o			

330 Ft. from N. Line

_____ Ft. from S. Line

_____ Ft. from E. Line

990 Ft. from W. Line

PEACE CREEK POOL

Location _____

Rig up _____

Drilling and Remarks:

Moving in Rotary Total-Depth _____

RECORD

Cased _____ in., _____ ft.

Sand _____

Gas _____

Oil _____

PRODUCTION

1st 24 hrs. Nat. _____

1st 24 hrs. after shot _____

Gas _____ Cu. Ft.

Dry Hole _____

Abandoned _____

Date

DEC 3 1941 19S. J. LEWIS Scout

Map No. 47 Sec. 22 Twp. 23 R. 10WWell No. 3 SnowbargerCities Service Oil CompanyCOMPLETED Contractor

NE NW NW

330 Ft. from N. Line

_____ Ft. from S. Line

_____ Ft. from E. Line

990 Ft. from W. Line

SECTION PLAT

o			

PEACE CREEK POOL

Location _____

Rig up _____

Drilling and Remarks:


RECORD

Cased _____ in., _____ ft.

Sand _____

Gas _____

Oil _____


PRODUCTION

1st 24 hrs. Nat. _____

1st 24 hrs. after shot _____

Gas _____ Cu. Ft.

Dry Hole _____

Abandoned _____

Date

JAN 7 1942 19S. J. LEWIS Scout