


Section 22 Township 23 Range 10-W

Well No. #5 Snowbarger

Company Cities Service Oil

NORTH Peace Creek Pool

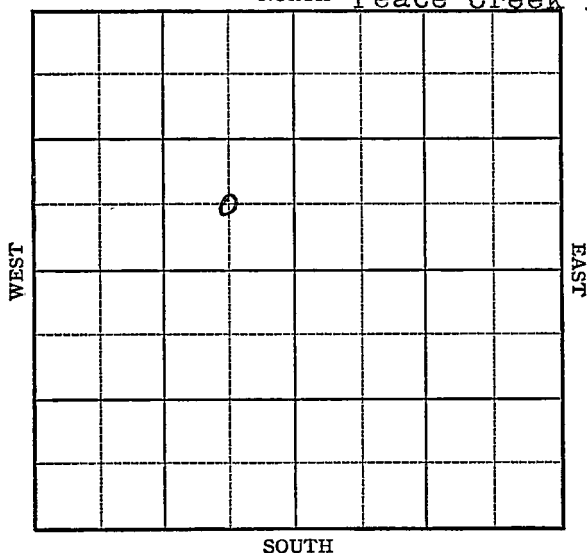


Sec. 22 Twp. 23 R. 10-WWell No. #5 Snowbarger FarmCities Service Oil Company

(Peace Creek)

 Ft. from N. Line660 Ft. from S. Line660 Ft. from E. Line Ft. from W. Line

Elev. 1774

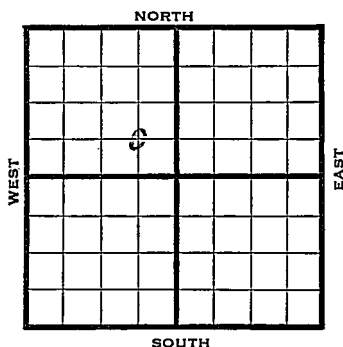

1942

REPORT

7/1 Drlg. 100'

7/8 10" - 154' Drlg. 1943'

7/15 Drlg. 3660'

7/22 Lans. 3303 Miss. 3634
Kind. 3660 Viola 3793-95 T.D.
5" - 3793 - 300 oil.

7/29 Flow 18 oil P.H. 6 hrs.

8/5 Viola 3793'
5" - 3793'
T.D. 3795'
Bomb Pot. 3000
Gravity 42.

COMPLETED

Map No. 47 Sec. 22 Twp. 23 R. 10WWell No. 5 Snowbarger

Cities Service Oil

Company

FIRST REPORT

Contractor

C S E N W

SECTION PLAT

	o		

Ft. from N. Line

660

Ft. from S. Line

660

Ft. from E. Line

Ft. from W. Line

PEACE CREEK POOL

Location

Rig up

Drilling and Remarks:

Drlg. 100'

RECORD

Cased _____ in., _____ ft.

Sand _____

Gas _____

Oil _____

Total Depth _____

PRODUCTION

1st 24 hrs. Nat. _____

1st 24 hrs. after shot _____

Gas _____ Cu. Ft.

Dry Hole _____

Abandoned _____

Date

JUL 1 1942

19

S. J. LEWIS

Scout

KANSAS

Reno

Map No. 47 Sec. 22 Twp. 23 R. 10WWell No. 5 SnowbargerCities Service Oil CompanyCOMPLETED Contractor

C S E NW

SECTION PLAT

 Ft. from N. Line660 Ft. from S. Line660 Ft. from E. Line Ft. from W. Line

	o		

PEACE CREEK POOLLocation Rig up

Drilling and Remarks:

*Viola 3793**5" @ 3793**Born + 2 x 3000**420 G*

RECORD

Cased in., ft.Sand Gas Oil Total Depth 3795

PRODUCTION

1st 24 hrs. Nat. 1st 24 hrs. after shot Gas Cu. Ft.Dry Hole Abandoned

Date

AUG 5 1942

19

S. I. LEWIS Scout