

Stafford

KANSAS

DX 78-1

Section 22 Township 23 Range 12W

Well No. #1 Thole

Company O.A.Sutton

NORTH

WEST

EAST

		0					

SOUTH

SEC.	TWP.	R.
22	23	12W

WELL NO.

#1 Thole

FARM

COMPANY

O. A. Sutton

CONTRACTOR

Gabbert-Jones

Semi-Wildcat

330


Ft. from N. Line

Ft. from S. Line

990

Ft. from E. Line

Ft. from W. Line

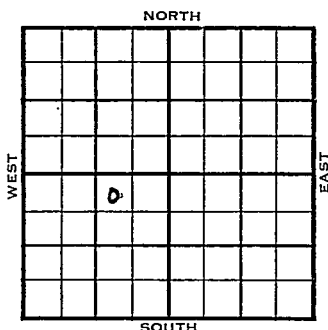

NW NE SW

Sunray F/O & DHM NCRA - AC.

	ELEVATION	REPORT
1954	1848'	

11/3
11/23

M I R
Spud 11-3-54
D & A
TD 3885'
8-5/8" @ 246'
Lans 3380'
DST 3548'-54' opn 15 min, rec 15' Mud
170#
DST 3619'-38' opn 1/2 hr, rec 15' Mud
1120# Viola 3715'
DST 3726'-65' opn 1 1/2 hr, rec 75' Mud
850# Simp 3768' Arb. 3850'
TD 3885'
D & A

ABANDONED


County **Stafford** State **Kansas**Sec. **22** (Blk. Twp.) **23** (Sur. Rge.) **12W** Map No.Operator **O. A. Sutton**Well No. **1** Farm **Thole**Elev. Location **NW NE SW**

FIRST REPORT									

330 Ft. From **N** Line **SW**990 Ft. From **E** Line Quarter1st. Report **NOV 3 1954**Completion **Sunray FC & DEM**Remarks **NCRA - AC****Gabbert-Jones - Contr.**

Spudding Date

Drlg. Data **Semi Wildcat**
MIR**FABEN GILSTRAP**

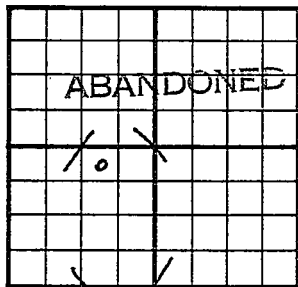County Stafford State KansasSec. 22 (Blk. Twp.) 23 (Sur. Rge.) 12W Map No.Operator O. A. SuttonWell No. 1 Farm TholeElev. 1848 Location NW NE SW330 Ft. From N Line SW990 Ft. From E Line Quarter

1st. Report

Completion NOV 23 1954Remarks Semi WildcatGabbert-Jones - Contr.Spudding Date 11-3-54Drig. Data D & A TD 38858 5/8" @ 246 Lans. 3380 DST 3548-54open 15 min. Rec. 15' mud 170#DST 3619-38 open 1/2 hr. Rec. 15' mud1120# Viola 3715 DST 3726-65 open1 1/2 hr. Rec. 75' mud 850# Simp. 3768Arb. 3850 TD 3885D & A

FABEN C. L. STRAP