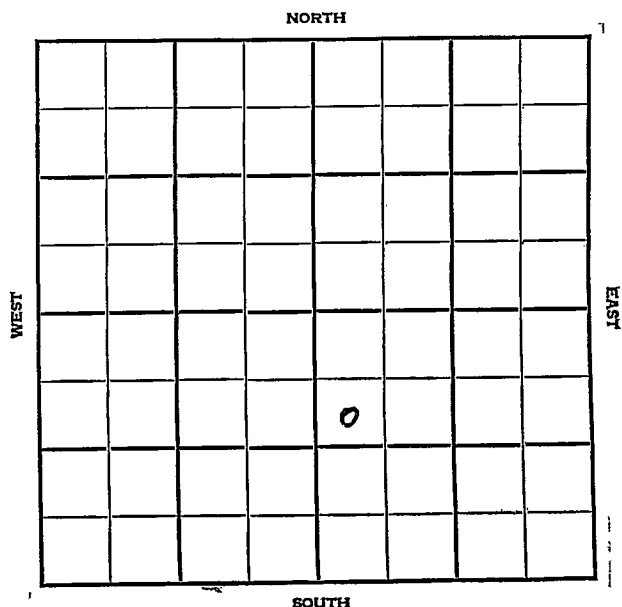


Section 22 Township 23 Range 11WWell No. 1 AdamsonCompany Loffland Bros.

Stafford

KANSAS

SEC.	TWP.	R.
22	23	14 W

WELL NO.

1 Adamson

FARM

COMPANY

Loffland Bros.

CONTRACTOR

Co. tools

Wildcat


990 Ft. from N. Line

Ft. from S. Line

Ft. from E. Line

330 Ft. from W. Line

SW NW SE

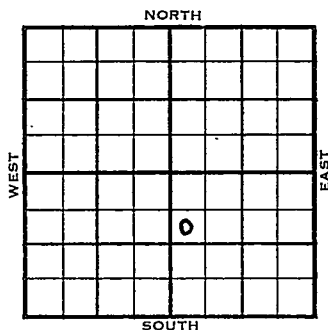

ELEVATION

REPORT

1955

1944'

2/2

Spud 1-30-55

8" @ 215'

Drlg. 1470'

2/16

Spud 1-30-55 - D&A

TD 4080'

8" @ 215'

Heeb. 3420', Tor 3554', Lans 3566'

DST 3721-51, opn 1 hr., rec. 100' wm, 1152#

DST 3750-75', opn 1 hr., rec. 8' mud, 30#

TD 4080'

Schl Tops: Anhy 858', Heeb. 3420',

Tor. 3440', Doug. 3457', Iatan 3556',

Lans 3569', B KC 3823', Sh. Cong.

3892', Ch. Cong. 3922', Ch. Viola

3942', Simp. 4001', Arb. 4048'

TD 4080'

D&A

ABANDONED

County Stafford State Kansas
 Sec. 22 (Blk.) 23 (Sur.) 1 NW Map No.
 Operator Loffland Bros.
 Well No. 1 Farm Adamson
 Elev. _____ Location SW NW SE

FIRST REPORT

990 Ft. From N Line SE
330 Ft. From W Line Quarter
 1st. Report FEB 2 1955

Completion _____

Remarks _____


Co. tools

Spudding Date 1-30-55

Drlg. Data Wildcat

8" @ 215 drlg. 1470

FABEN GILSTRAP

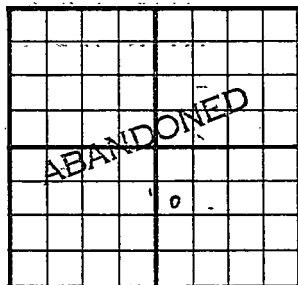County Stafford State KansasSec. 22 (Blk. Twp.) 23 (Sur. Rge.) 14W Map No.Operator Loffland Bros.Well No. 1 Farm AdamsonElev. 1944 Location SW NW SE990 Ft. From N Line SE330 Ft. From W Line Quarter

1st. Report

Completion FEB 16 1955Remarks WildcatCo. toolsSpudding Date 1-30-55Drlg. Data D & A TD 40808" @ 215 Heeb. 3420 Tor. 3554Lans. 3566 DST 3721-51 open 1 hr.Rec. 100' wm 1152# DST 3750-75open 1 hr. Rec. 8' mud 30# TD 4080SCHLUMBERGER TOPS:Anhy 858 Heeb. 3420 Tor. 3440Doug. 3457 Iatan 3556 Lans. 3569B KC 3823 Sh. Cong. 3892 Ch. Cong. 3922Ch. Viola 3942 Simp. 4001 Arb. 4048TD 4080.D & A

FABEN GILSTRAP