


Section 22 Township 23 Range 14W

Well No. #1 Hon Hohner

Company Westgate-Greenland

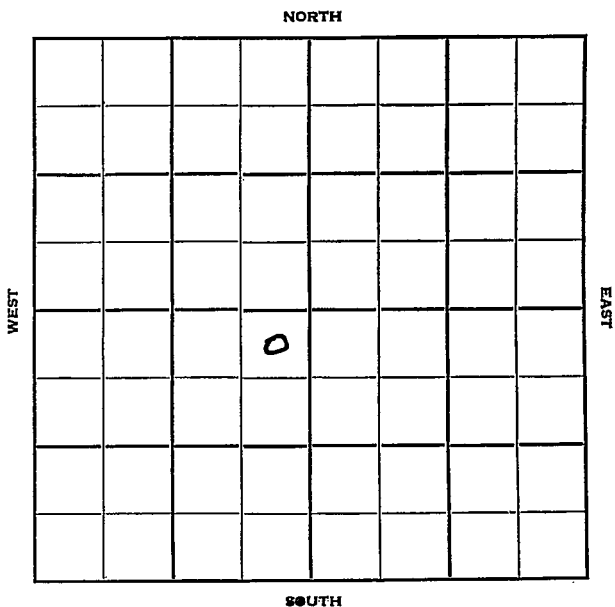

Sec. 22 Twp. 23 R. 14 W

Well No. # 1 Hon Hohner Farm

Westgate-Greenland Company

Wildcat Contractor


330 Ft. from N. Line

_____ Ft. from S. Line

330 Ft. from E. Line

_____ Ft. from W. Line

NE NE SW

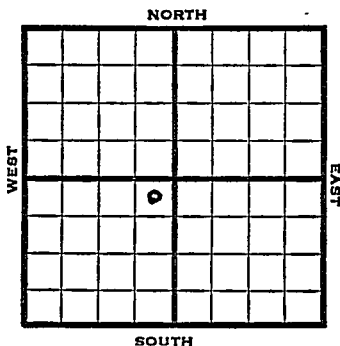

1952

Elev. 1939 REPORT

8/6 Spud 7-31-52 -
8" @ 235 Anhy 850'
Drlg. 2530'

8/13 Heeb. 3417 Tor. 3437
Br Li 3553 Lans. 3566
B KC 3817 Marm 3823
Marm chert 3880 Miss 3874
KH 3888 V 3908
Simp. 4010 Arb: 4037
RTD 4067 Schl. D&A

8/20 Spud 7-31-52 D&A TD 4067
8" @ 235 Anhy 850 Heeb. 3417
Tor. 3437 Br lime 3553
Lans. 3566 BKC 3817
Marm. 3823 Marm. Ch. 3880
Miss 3904 Kh. 3888 Viola 3941
Simp 4010 Arb. 4037 TD 4067
D&A

ABANDONED

4037
1939

2098

