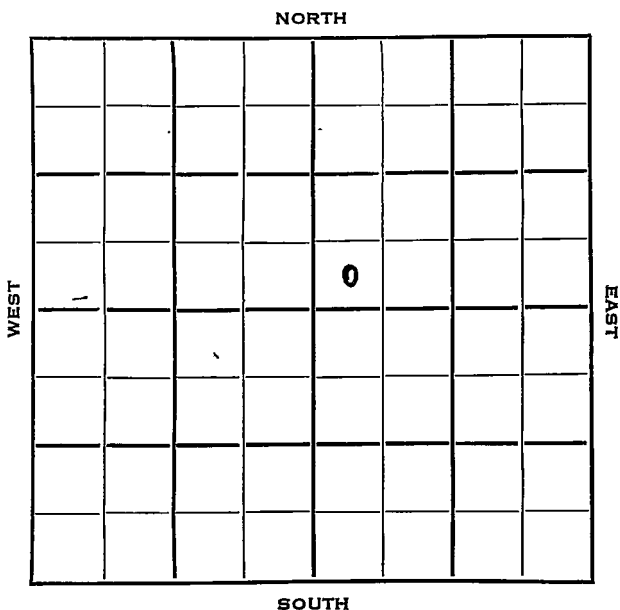


Section 22 Township 23 Range 16 WWell No. # 1 YeagerCompany T. H. Mastin

Pawnee KANSAS

SEC.	TWP.	R.
22	23	16W ✓

WELL NO.

1 Yeager

FARM

COMPANY

T. H. Mastin

CONTRACTOR

Isern Drlg.


Wildcat

_____ Ft. from N. Line

330 _____ Ft. from S. Line

_____ Ft. from E. Line

330 _____ Ft. from W. Line

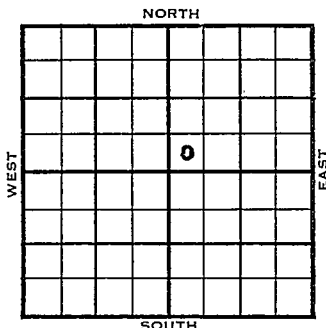

SW SW NE

	ELEVATION	REPORT
1953	2054'	

11/18 Spud 11-13-53
8" @ 312'
Drlg. 1935'

12/2 Spud 11-13-53
D & A TD 4146' 8" @ 312'
Heeb 3539 Br. lime 3662' Lans 3671
DST 3676-3708, open 1 hr rec 183' SO
& GCM 1125# B KC 3933' Cong. 4048'
Simp. sh. 4076' Simp. dol. 4099'
DST 4099-4105 open 1 hr rec 150' gas,
25' SGCM 60# Arb. 4120
TD 4146' D & A

ABANDONED

County **Pawnee** State **Kansas**

Sec. 22 (Blk. Twp.) 23 (Sur. Rge.) 16W Map No.

Operator T. H. Mastin

Well No. 1 Farm Yeager

Elev.	2054	Location	SW SW NE
-------	------	----------	----------

0

FIRST REPORT

330 Ft. From S Line NE

330 Ft. From ~~FT~~ Line Quarter

1st. Report NOV 18 1953

Completion

Remarks


Isern Drig. - Contr.

Spudding Date 11-13-53

Drlg. Data Wildcat

8" @ 312 drlg. 1935

County Pawnee State Kansas
 Sec. 22 (Bk.) 23 (Sur.) 16W Map No.
 Operator T. H. Mastin
 Well No. 1 Farm Yeager
 Elev. 2054 Location SW SW NE

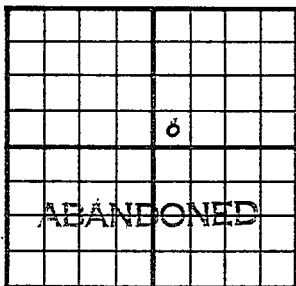

330 Ft. From S Line NE
330 Ft. From W Line Quarter
 Ist. Report
 Completion DEC 2 1953
 Remarks Wildcat
Isern Drlg. - Contr.
 Spudding Date 11-13-53

Drlg. Data D & A TD 4146
8" @ 312 Heeb. 3539 Br. lime 3662
Lans. 3671 DST 3676-3708 open 1 hr.
Rec. 183' so & gcm 1125# B KC 3933
Cong. 4048 Simp. sh. 4076 Simp. dol.
4099 DST 4099-4105 open 1 hr. Rec.
150' gas 25' sgcm 60# Arb. 4120
TD 4146

D & A