

Finney

KANSAS

22

23S

32W

SECTION _____ TOWNSHIP _____ RANGE _____

#1 Grain G.U.


WELL NO. _____

Pan Amer.

COMPANY _____

NORTH

C SE/4

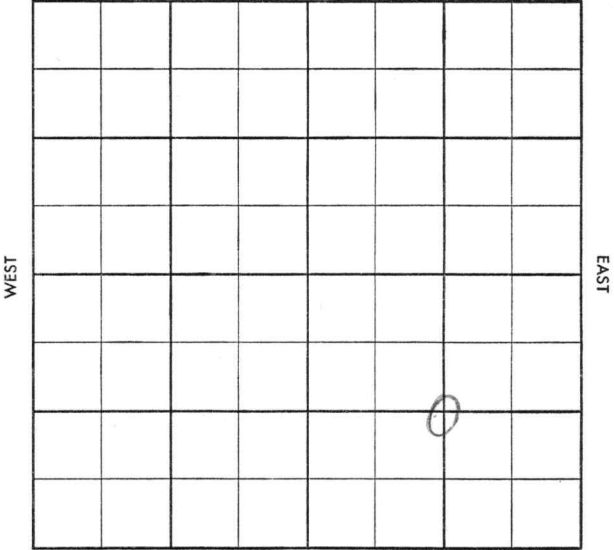

SOUTH

CO. ~~Finney County~~ ELEV. ~~29200~~
SEC. ~~22~~ TWP. ~~23~~ RGE. ~~32W~~
COMPANY ~~Pan. Amer~~ NO. ~~1~~

CO.
NO.
SEC.
TWP.
RGE.

FARM Crain G.U.
LOC. G C SE/4

GEOL. _____
CONTR. Noble tools
POOL Hugoton
SPUD 12-1-57
Location SEC 4 37
8" 1085/700
Ø 2015
TD 2686 Log
Top Mem 2651
1K 2673 5 1/2"

2684/800 CO 2686 sgas
+w testing
SQ 48/2664-70 free
15x15 ga 2.35 2 mcf +ld
thru csg 12 hrs ga 2.542
mcf +ld 16 hrs testing
DEC 26 57 24-20 OP F16 ga
5.710 mcf 3" outlet
Sip 411 Mem 2664-70

CO.
NO.
SEC.
TWP.
RGE.