


Section 22 Township 23 Range 33W

Well No. #1 E. Rewerts

Company Northern Pump

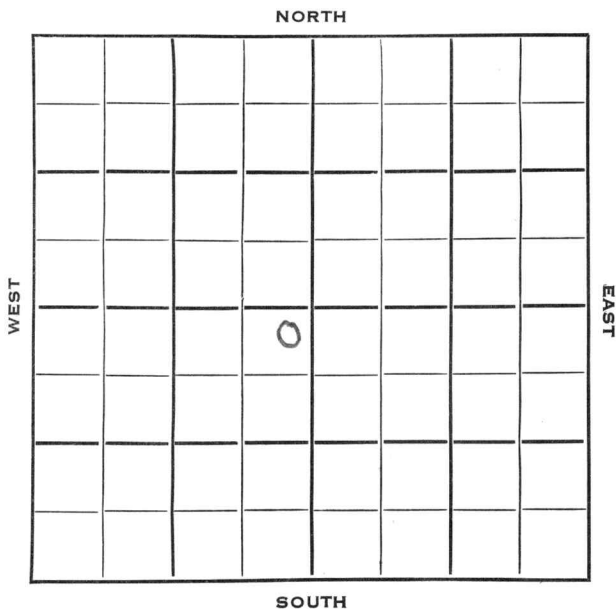



Sec. 22 Twp. 23 R. 33 W

Well No. # 1 E. Rewerts Farm

Northern Pump Company

Hugoton Pool Contractor


150 Ft. from N. Line

_____ Ft. from S. Line

150 Ft. from E. Line

_____ Ft. from W. Line

NE SW

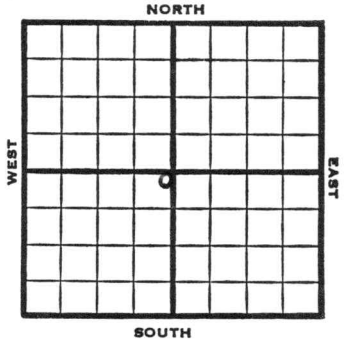

1953

Elev. 2899' REPORT

5/6

Spud 4-29-53
 10" @ 364 Her. 2548' Kri. 2570
 Win. 2610'
 TD 2615' 7" @

5/21

7" @ 2612
 CO 2600'

5/27

NR

6/3

Spud 4-29-53 Gas well TD 2615
 10" @ 364 Her. 2548 Kri 2570
 Win 2610 TD 2615 7" @ 2612
 CO to 2600 30/2606-11 2000 A
 dol-frac. PB 2592 108/2572-90
 102/2545-62 dol-frac. CO to 2615
 2000 A
 Comp. 12,448,000 gas. 410#

COMPLETED

County **Finney** State **Kansas**

Sec. **22** (Blk. Twp.) **23** (Sur. Rge.) **33W** Map No.

Operator **Northern Pump**

Well No. **1** Farm **E. Rewerts**

Elev. Location **NE SW**

FIRST REPORT					

150 Ft. From **N** Line **SW**

150 Ft. From **E** Line Quarter

1st. Report **MAY 6 1953**

Completion

Remarks

Spudding Date **4-29-53**

Drlg. Data **Hugoton Pool**

10" @ 364 Her. 2548 Kri. 2570

Win. 2610 TD 2615 7" @

