

DX 78-1


KANSAS

Kearny

Section 22 Township 23 Range 35W

Well No. #1 Corse

Company Kansas Natural

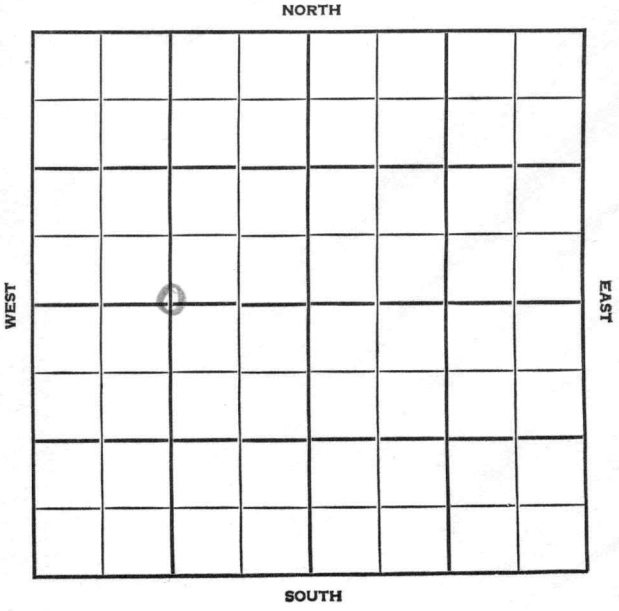

Kearny

KANSAS

SEC. 22	TWP. 23	R. 35W
------------	------------	-----------

WELL NO.
1 Corse FARM

COMPANY
Kansas Natural

CONTRACTOR

Hugoton Pool


2640' _____ Ft. from N. Line

_____ Ft. from S. Line

_____ Ft. from E. Line

1320' _____ Ft. from W. Line

C W 1/2 Sec

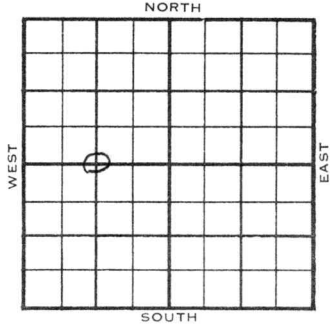

1955	ELEVATION 3024'	REPORT
------	--------------------	--------

5/25 **Loc.**

8-24 10 3/4" @ 408, 7" @ 2659/100
56/ 2639-53 500 A, frac 500 A
Comp. 4,750 mcf/gpd.
H. Herr., 2524, Tr. Kri. 2540, Dg. Winf.,
2570, B.L. Ft. Riley, 2638, T.D. 2660

COMPLETED

County Kearny State Kansas

Sec. 22 (Blk. 23 (Sur. 35W Map No.
Twp. (Rge.)

Operator Kansas Natural

Well No. 1 Farm Corse

Elev. _____ Location C W $\frac{1}{2}$ Sec.

2640Ft. From N Line Sec.

1320Ft. From W Line Quarter

Ist. Report MAY 25 1955

Completion _____

Remarks _____

Spudding Date _____

Drlg. Data Hugoton Pool

Location _____

1C-34

County Kearny Elev. 3024
 Sec. 22 Twp. 23 Rge. 35W
 Company Kansas Natural
 Farm Name Corse No. 1

TOPS	DEPTH	LOG	DATUM
Anh.			
Tp.			
H. <u>Wen</u>		<u>2524</u>	
Tr. <u>Ksi</u>		<u>2570</u>	
Dg. <u>Wand</u>		<u>2570</u>	
Bl. <u>7+Bluf</u>		<u>2638</u>	
L.			
K.C.			
B.K.C.			
Ce.			
C.			
M.			
M.			
K.			
Mz.			
Mq.			
V.			
S.			
S.			
A.			
R.			
Pf.			
G.			
T.D.	<u>2160</u>		

Loc. in Sec. _____
C W $\frac{1}{2}$ Sec.
 Geol. _____
 Contr. _____
 Pool _____



Date Comm. AUG 24 1955
10 3/4" @ 408 7" @ 2659/100
56/ 2639-53 500 A frac 500 A
Comp. 1,750 mcfgpd

Co.
Lse.
No.
Sec.
T.
R.