


SECTION 22 TOWNSHIP Kearny 23 RANGE KANSAS 35 W

WELL NO. #1 Jones

COMPANY Michalis Drlg.

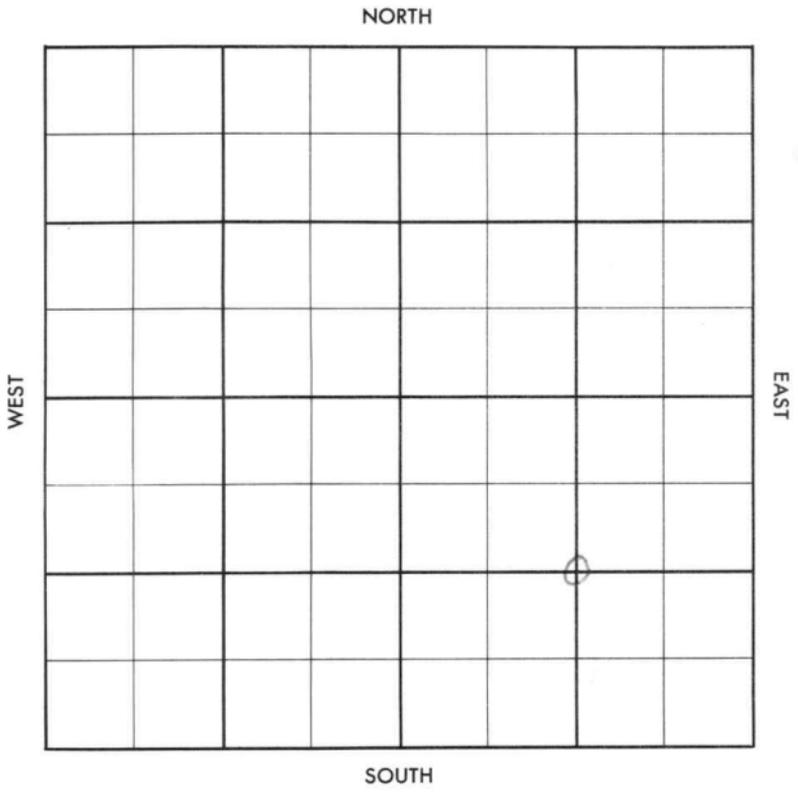

Kearny

KANSAS

SEC. 22	TWP. 23	R. 35W
------------	------------	-----------

WELL NO.

#1 Jones

FARM

COMPANY

Michaelis Drlg.

CONTRACTOR


_____ Ft. from N. Line

_____ Ft. from S. Line

_____ Ft. from E. Line

_____ Ft. from W. Line

C SE/4

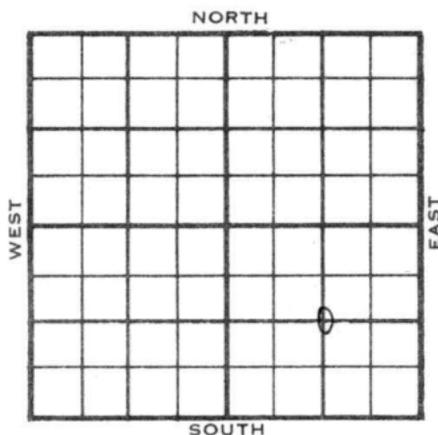

1955

ELEVATION

3021'

REPORT

12-14

Comm. 12-12-55

8" @ 421/20

WOC

1956

1-18

5 1/2" @ 2675

CO. to 2655, 36/ 2642-50, 24/ 2594-

2600, frac, 2594-2600, 1000 A

1,426 mcfg

32/ 2530-38, 40/ 2548-58, sd-frac

Comp. 10,105 mcfgpd.

Log tops: Herr. 2508

Kri 2529

Tow. 2641

TD 2676'

COMPLETED

County Kearny Elev. _____
 Sec. 22 Twp. 23 Rge. 35W
 Company Michaelis Drlg.
 Farm Name Jones No. 1

TOPS	DEPTH	LOG	DATUM
Anh.			
Tr.			
H.			
Tr.			
Dg.			
B.L.			
L.			
K.C.			
B.K.C.			
Ce.			
C.			
M.			
M.			
K.			
Mz.			
Me.			
V.			
S.			
S.			
A.			
R.			
Pe.			
G.			
T.D.			

Loc. in Sec. C SE/4
 Geol. _____
 Contr. _____
 Pool _____



Date Comm. 12-12-55
8# @ 421/200 WOC

34

Co.
Lse.
No.
Sec.
T.
R.

County Kearny Elev. 3021
 Sec. 22 Twp. 23 Rge. 35W
 Company Michaelis Drlg.
 Farm Name Jones No. 1

TOPS	DEPTH	LOG	DATUM
Anh.			
Tr.			
L.			
K.C.			
B.K.C.			
Ce.			
C.			
M.			
M.			
K.			
Mz.			
Mq.			
V.			
S.			
S.			
A.			
R.			
Pe.			
G.			
T.D.	<u>2676</u>		

Loc. in Sec. C SE/4

Geol. _____

Contr. _____

Pool _____



Date Comm. 12-12-55 JAN 1 8 1956

8" @ 421/200 5 1/2" @ 2675 CO to 2655

36/ 2642-50 24/ 2594-2600 frac

2594-2600 1000 A 1,426 mcfg

32/ 2530-38 40/ 2548-58 sd-frac

Comp. 10,105 mcfgpd

Co.

Lse.

No.

Sec.

T.

R.