

Keno

23 Twp. 23 R. 4w

3 Blake Farm
Olsen & Shell Company

15



EAST

SOUTH

Rig Up_____

Drilling Remarks

PRODUCTION

1st 24 hrs. Nat.-----

1st 24 hrs. after shot-----

Gas _____ cu. ft. _____


Dry Hole_____

Abandoned_____

Reno

Map No. KANSAS Sec. 23 Twp. 23 R. 4W
Well No. 3 Blake Farm
Allen & Shell Company

 Ft. from N. Line
610 Ft. from S. Line
 Ft. from E. Line
660 Ft. from W. Line

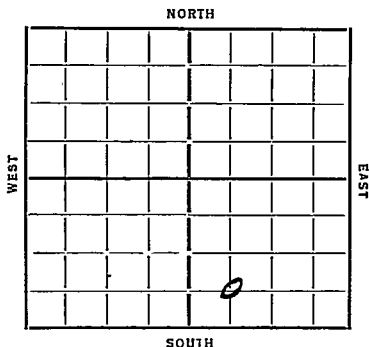

Date	REPORT
11/14	Rig
11/22	11/28
12/6	15' 2 256
12/13	Olg 2274
12/21	" 2960
12/27	
1/3/35	Chat 3247 8" 3268
	10 M Gas 3305
1/10	17 M 3321 Rev 5" 3323
1/17	Mudding off Gas
1/24	1/31 - 2/7
2/14	No shut off on Gas
2/21	Olg 3355
2/28	" 3370
3/6	Chat 3247 T 7 3370
	299 Bbl.

COMPLETED

Map No. 40 Sec. 23 Twp. 23 R. 4W

Well No. 3-Beake

Olsen + Shell Company

Contractor

FIRST REPORTS

_____ Ft. from N. Line

610 Ft. from S. Line

_____ Ft. from E. Line

660 Ft. from W. Line

SECTION PLAT

		0	

Location _____

Rig up _____

Drilling and Remarks:

Rig

RECORD

Cased _____ in., _____ ft.

Sand _____

Gas _____

Oil _____

Total Depth _____

PRODUCTION

1st 24 hrs. Nat. _____

1st 24 hrs. after shot _____

Gas _____ Cu. Ft.

Dry Hole _____

Abandoned _____

Date

ORVAL MANNSCHRECK

11-14-34 19

Scout

Map No. 40 Sec 23 Twp 23 R. 4W

Well No. 3-Beake

Olsen & Shell Company

Contractor

~~COMPLETED~~

SECTION PLAT

		0	

Ft. from N. Line

610

Ft. from S. Line

Ft. from E. Line

660

Ft. from W. Line

Location

Rig up

Drilling and Remarks:

299 fms

RECORD

Cased in. ft.

Sand Chat 3247

Gas

Oil

Total Depth 3370

PRODUCTION

1st 24 hrs. Nat.

1st 24 hrs. after shot

Gas Cu. Ft.

Dry Hole

Abandoned

Date

ORVAL MANNSCHRECK

3-6-30

192

Scout