


Map No. **KANSAS** Sec. **23** Twp. **23** R. **4W**
 Well No. **5 Blake** Farm
Olsen & Shell Company

Reno

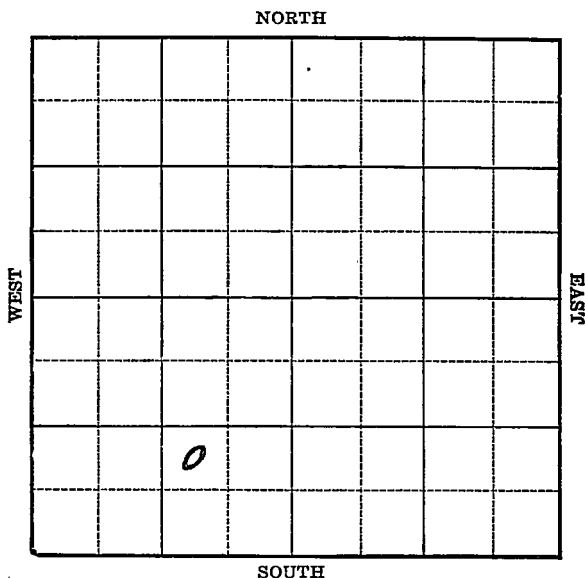

Location _____
 Drilling Remarks _____

Rig Up _____
 Drilling Remarks _____

RECORD

Cased _____ in. _____ ft.
 Sand _____
 Gas _____
 Oil _____
 Total Depth _____

PRODUCTION

1st 24 hrs. Nat. _____
 1st 24 hrs. after shot _____
 Gas _____ cu. ft.
 Dry Hole _____
 Abandoned _____

Reno

Map No. *SA* Sec. *23* Twp. *23* R. *4W*


Well No. *5 Blake* Farm
Olson & Shell Company

_____ Ft. from N. Line

990 Ft. from S. Line

990 Ft. from E. Line

_____ Ft. from W. Line

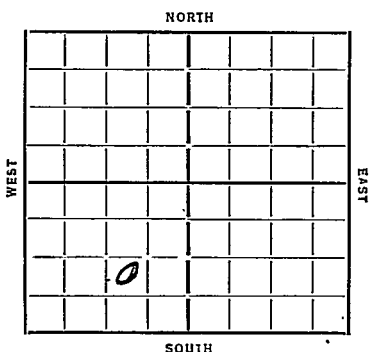

Date *1/25*

REPORT

1/2 Location
1/10 Celler
1/17 Rig
1/24 18 1/2 262 WOC
1/31 Wly 1751
2/7 " 2720
2/14 " 2970
2/21 " 3454 Chat 3258
2/28 Hunter 3590 7" 3590 Rust
3/7 T7 3614 Flow 70 Bbls per hr
3/13 Hunter 3590 T7 3614
2000 acil 2190 Bbls Cut 4%.

COMPLETED

Map No. 40 Sec. 23 Twp. 23 R. 4W

Well No. 5-Blake

Olsen & Shell Company

Contractor

FIRST REPORTS

Ft. from N. Line

990 Ft. from S. Line

990 Ft. from E. Line

Ft. from W. Line

SECTION PLAT

Location ✓

Rig up

Drilling and Remarks:

RECORD

Cased in., ft.

Sand

Gas

Oil

Total Depth

PRODUCTION

1st 24 hrs. Nat.

1st 24 hrs. after shot

Gas Cu. Ft.

Dry Hole

Abandoned

Date

1-2-35 192 ORVAL MANNSCHRECK Scout

Map No. 40 Sec. 23 Twp. 23 R. 4W

Well No. 5-Blake

Olsen & Shell Company

Contractor

COMPLETED

SECTION PLAT

Ft. from N. Line

990 Ft. from S. Line

990 Ft. from E. Line

Ft. from W. Line

	0		

Location

Rig up

Drilling and Remarks:

2000 and

2190 bbls
cut 470

RECORD

Cased in. ft.

Sand Hunter 3590

Gas

Oil

Total Depth 3614

PRODUCTION

1st 24 hrs. Nat.

1st 24 hrs. after shot

Gas Cu. Ft.

Dry Hole

Abandoned

Date

3-13-35 192

GEORGE W. HANNSCHRECK

Scout