


Section 23 Township 23 Range 10W

Well No. 10 Blake

Company S & K Oil

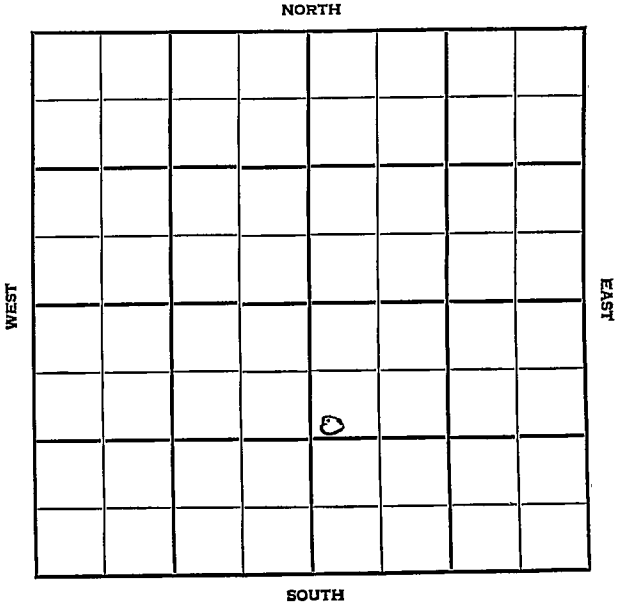

Reno

KANSAS


SEC. 23	TWP. 23	R. 4 W
---------	---------	--------

WELL NO. # 10 Blake FARM

COMPANY S & K Oil

CONTRACTOR Buick
Burbton

_____ Ft. from N. Line
 _____ Ft. from S. Line
 _____ Ft. from E. Line
 _____ Ft. from W. Line

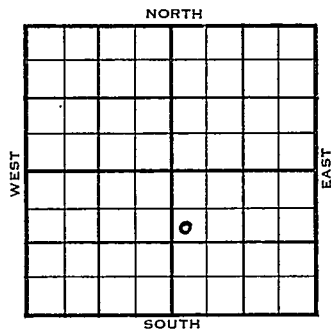

SW NW SE

ELEVATION	REPORT
1955	
7/13	<p>Comm. 5-8-55 13" @ 309/1068 DST 3353-86 open 1 hr rec 25' mud 0# 7" @ 3836/1650 CO to 5008 1500 A Comp. SWD well L. 2538', M. 3252', K. 3495', Hunton 3608', Arb. 3820', G. wh. 4450' TD 5008'</p> <p>FIRST REPORT ↓ ABANDONED</p>

County Reno Elev. 1468
 Sec. 23 Twp. (23) Rge. 4W
 Company S & K Oil
 FarmName Blake No. 10

TOPS	DEPTH	LOG	DATUM
Anh.			
Tp.			
H.			
Tr.			
Dg.			
BL.			
L.	<u>2538</u>		<u>1070</u>
K.C.			
B.K.C.			
Ce.			
C.			
M.	<u>3252</u>		<u>1784</u>
M.			
K.	<u>3495</u>		<u>2027</u>
Mz. <u>Huntton</u>	<u>3608</u>		<u>2140</u>
Me.			
V.			
S.			
S.			
A.	<u>3820</u>		<u>2350</u>
R.			
PE.			
G. <u>11th.</u>	<u>4450</u>		<u>2992</u>
T.D.	<u>5008</u>		<u>3540</u>

Loc. in Sec. SW NW SE
 Geol. _____
 Contr. _____
 Buick
 Pool
 Burrton

**FIRST REPORT
 ABANDONED**

Date Comm. 5-8-55 JUL 13 1955
13" @ 309/1068 DST 3353-86 open 1 hr.
Rec. 25' mud 0# 7" @ 3836/1650
CO to 5008 1500 A Comp. SWD well

Co.
 Lse.
 No.
 Sec.
 T.
 R.