

23

23


4w

NO. 722 DATE 5 Dec. 1941 P. 1 WP. 1
#6 ~~7~~ Duckworth
No. Olsen & Shell

Farm

Company

NORTH

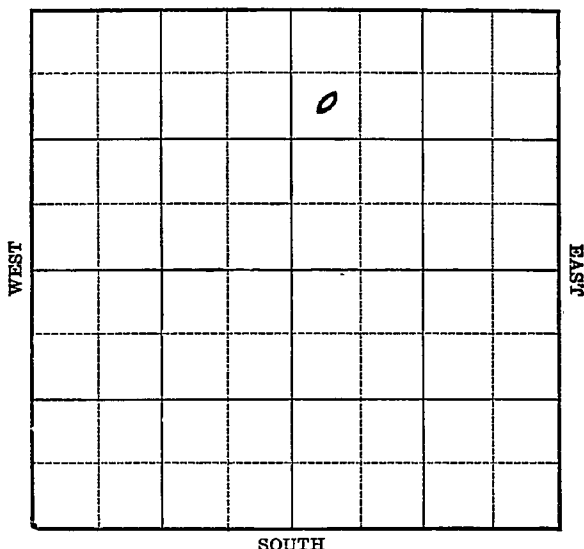

2

Rig Up_____

Drilling Remarks

PRODUCTION

1st 24 hrs. Nat.-----

1st 24 hrs. after shot-----

Gas _____cu. ft._____


Dry Hole-----

Abandoned_____

Reno

Map No. 23 Sec. 23 Twp. 23 R. 4W
Well No. #6 ~~23~~ *Duckworth* Farm
Olsen & Shell Company

990 Ft. from N. Line
 Ft. from S. Line
 Ft. from E. Line
330 Ft. from W. Line

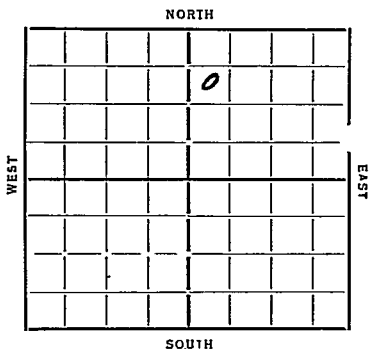

Date

REPORT

7/35
7/13 Location
7/31 Material
7/28 Rig
8/7
8/4 Log 1356 15" 260
8/21 " 2385
8/28 " 3075
4/4 Chat 3346 pipe stuck 3471
4/11 Hunter 3592 7" 3592 Rust
4/18 3606 14 FQ Log
4/26 583 Bbls Nat
5/1 Hunter 3592 T 7 3606
1491 Bbls.

COMPLETED

Map No. 40 Sec. 23 Twp. 23 R. 4W

Well No. 7- Duckworth

Olsen + Shill Company

Contractor

FIRST REPORTS

SECTION PLAT

990 Ft. from N. Line

..... Ft. from S. Line

..... Ft. from E. Line

330 Ft. from W. Line

KANSAS

		0	

Location ✓

Rig up

Drilling and Remarks:

RECORD

Cased.....in.,ft.

Sand.....

Gas.....

Oil.....

Total Depth.....

PRODUCTION

1st 24 hrs. Nat.....

1st 24 hrs. after shot.....

Gas.....Cu. Ft.

Dry Hole.....

Abandoned.....

Date

ORVAL MANNSCHRECK

2-13-35 192

Scout

Map No. 40 Sec. 23 Twp. 23 R. 4WWell No. 6 - DuckworthOlson & Shell Company

Contractor

CORRECTION

SECTION PLAT

		0	

990 Ft. from N. Line

Ft. from S. Line

Ft. from E. Line

330 Ft. from W. Line

CORRECTION

Location

Rig up

Drilling and Remarks:

This reported
as #7. Has
now been
changed
to #6.

RECORD

Cased in., ft.

Sand

Gas

Oil

Total Depth

PRODUCTION

1st 24 hrs. Nat.

1st 24 hrs. after shot

Gas Cu. Ft.

Dry Hole

Abandoned

Date

ORVAL MANNSCHRECK

2-25-35 192 Scout

CORRECTION

Map No. 40 Sec. 23 Twp. 23 R. 4WWell No. 6-DuckworthOlsen & Shell Company

Contractor

COMPLETED

SECTION PLAT

990 Ft. from N. Line

Ft. from S. Line

Ft. from E. Line

330 Ft. from W. Line

		0	

Location

Rig up

Drilling and Remarks:

1491 Rbbs

RECORD

Cased _____ in., _____ ft.

Sand Huntton 3592

Gas _____

Oil _____

Total Depth 3606

PRODUCTION

1st 24 hrs. Nat. _____

1st 24 hrs. after shot _____

Gas _____ Cu. Ft.

Dry Hole _____

Abandoned _____

Date

5-1-35 192GEORGE MANN SCHRECK
Scout