


Map No. KANSAS Secy 23 Typ. 23 R. 4W
 Well No. 2 Vansickle Farm
Marathon Company

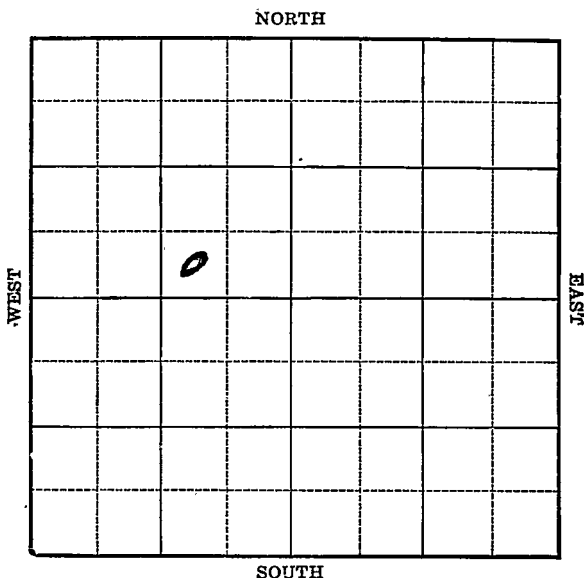

Location _____
 Drilling Remarks _____

Rig Up _____
 Drilling Remarks _____

RECORD

Cased _____ in. _____ ft.
 Sand _____
 Gas _____
 Oil _____
 Total Depth _____

PRODUCTION

1st 24 hrs. Nat. _____
 1st 24 hrs. after shot _____
 Gas _____ cu. ft.
 Dry Hole _____
 Abandoned _____

Reno


Map No. KANSAS Sec. 23 Twp. 23 R. 4W
Well No. 2 Vansickle Farm
Marathon Company

 Ft. from N. Line

330 Ft. from S. Line

990 Ft. from E. Line

 Ft. from W. Line

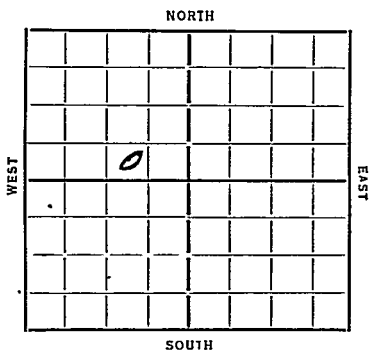

Date 1934

REPORT

12/12 Location
12/21 Rig
12/27 W 590
1/3/35 " 2530
1/10 " 3312 Chit 3250
1/17 Hutton 3602 7" 3602 Rust
1/24 3621 SW PB 1 ft 157 Bbls
2 1/2 hrs 1000 acid
1/30 Chit 3250 Hutton 3602
T 3621 1000 acid 1312 Bbls.

COMPLETED

Map No. 40 Sec. 23 Twp. 23 R. 4WWell No. 2-VansickleMarathon Company

Contractor

FIRST REPORT

SECTION PLAT

Ft. from N. Line

330 Ft. from S. Line990 Ft. from E. Line

Ft. from W. Line

		P	
	O		

Location ✓

Rig up

Drilling and Remarks:

RECORD

Cased in., ft.

Sand

Gas

Oil

Total Depth

PRODUCTION

1st 24 hrs. Nat.

1st 24 hrs. after shot

Gas Cu. Ft.

Dry Hole

Abandoned

Date

ORVAL MANNSCHRECK

12-12-31 192 Scout

Map No. 40 Sec. 23 Twp. 23 R. 4WWell No. 2-VansickleMarathon Oil Company

Contractor

COMPLETED

SECTION PLAT

	0		

Ft. from N. Line

330 Ft. from S. Line990 Ft. from E. Line

Ft. from W. Line

Location

Rig up

Drilling and Remarks:

1000 and1312 fth

RECORD

Cased _____ in., _____ ft.

Sand Chat 3250Gas Hutton 3602

Oil _____

Total Depth 3621

PRODUCTION

1st 24 hrs. Nat. _____

1st 24 hrs. after shot _____

Gas _____ Cu. Ft.

Dry Hole _____

Abandoned _____

Date

ORVAL MANNSCHRECK

1-30-35 192

Scout