


Map No. KANSAS Sec. 23 Twp. 23 R. 4WWell No. 2 Wilson FarmAmerada Pet. Company

NORTH

WEST

EAST

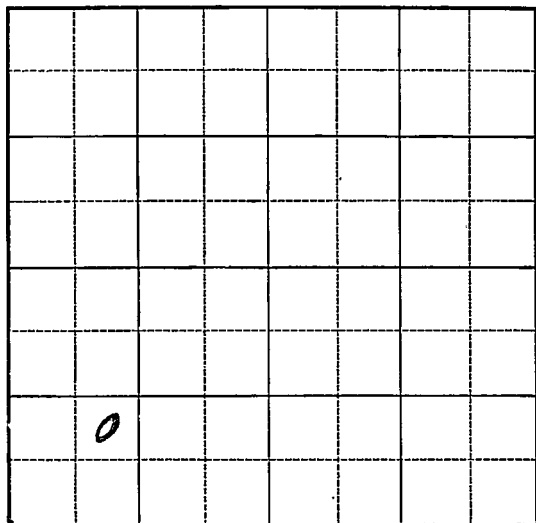

SOUTH

Location _____

Drilling Remarks _____

Rig Up _____

Drilling Remarks _____

RECORD

Cased _____ in. _____ ft.

Sand _____

Gas _____

Oil _____

Total Depth _____

PRODUCTION

1st 24 hrs. Nat. _____

1st 24 hrs. after shot _____

Gas _____ cu. ft.

Dry Hole _____

Abandoned _____

Map No. Sec. 23 Twp. 23 R. 4w

Well No. 2 Wilson Farm
Amerada Pet. Company

NORTH

Ft. from N. Line

990 Ft. from S. Line

Ft. from E. Line

990 Ft. from W. Line

WEST

EAST

SOUTH

Date 1/11/20

REPORT

12/5 Cellar

12/13	Rgn Rotary
-------	------------

12/21	15 1/2 495
-------	------------

12/27 *ds* 2352

1/2/35	"	2920
--------	---	------

9/1/8	" 3441 TML 3255
-------	-----------------

1/1/7 Newton 3596 8" 3596 Rust

11/24 TD 3606 Pot 2459 Nat

1 To Acidine

1/31	1000 acid	3397	Bbs
------	-----------	------	-----

Re acidic

2/6	Huntton	3596	T-1	3606
-----	---------	------	-----	------

2000 acid 4355 Bole

COMPLETED

Map No. 40 Sec. 23 Twp. 23 R. 4WWell No. 2-WilsonAmerada Pet Company

Contractor

FIRST REPORTS

SECTION PLAT

Ft. from N. Line

990 Ft. from S. Line

Ft. from E. Line

990 Ft. from W. Line

0			

Location

Rig up

Drilling and Remarks:

cellar

RECORD

Cased.....in.,ft.

Sand.....

Gas.....

Oil.....

Total Depth.....

PRODUCTION

1st 24 hrs. Nat.....

1st 24 hrs. after shot.....

Gas.....Cu. Ft.

Dry Hole.....

Abandoned.....

Date

ORVAL MANNSCHEIDT

12-5-34 192.....Scout

KANSAS

Map No. 40 Sec 23 Twp. 23 R. 4WWell No. 2-WilsonAmerada pet. Company

Contractor

COMPLETED

SECTION PLAT

0			

Ft. from N. Line

990 Ft. from S. Line

Ft. from E. Line

990 Ft. from W. Line

Location

Rig up

Drilling and Remarks:

2000 and4355 bbls

RECORD

Cased _____ in., _____ ft.

Sand Hunter 3596

Gas _____

Oil _____

Total Depth 3606

PRODUCTION

1st 24 hrs. Nat. _____

1st 24 hrs. after shot _____

Gas _____ Cu. Ft.

Dry Hole _____

Abandoned _____

Date

2-6-35 192**GRVAL MANNSCHRECK**

Scout