




*Revo*

Map No. KANSAS Sec. 73 Twp. 73 R. 4W

Well No. 3 Wilson Farm  
Amerada Pet. Company

990 Ft. from N. Line  
\_\_\_\_ Ft. from S. Line  
\_\_\_\_ Ft. from E. Line  
990 Ft. from W. Line

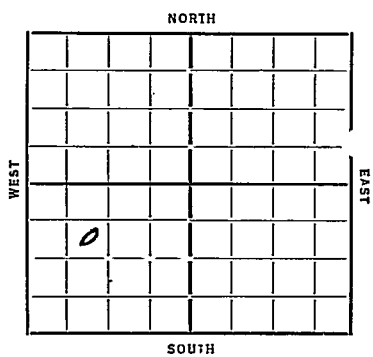

Date 1935

REPORT

1/30 Cellar  
2/7 15 1/2 250  
2/14 alg 1550  
2/21 " 2245  
2/28 " 2889  
3/7 " 3461 Chat 3260  
3/14 Misener 3602 Hutton 3604  
7" 3604 WOC  
3/21 3619 T17 25 Bbls per hr.  
3/28 1000 acid  
4/3 Hutton 3604 T17 3629  
PB 3619 1000 acid  
1475 Bbls.

COMPLETED

Map No. 40 Sec. 23 Twp. 23 R. 4 W

Well No. 3- Wilson

Amerada Pet Company

Contractor

FIRST REPORTS

SECTION PLAT

990 Ft. from N. Line

..... Ft. from S. Line

..... Ft. from E. Line

990 Ft. from W. Line

	0		

Location.....

Rig up.....

Drilling and Remarks:

*cellar*

RECORD

Cased.....in., .....ft.

Sand.....

Gas.....

Oil.....

Total Depth.....

PRODUCTION

1st 24 hrs. Nat.....

1st 24 hrs. after shot.....

Gas.....Cu. Ft.

Dry Hole.....

Abandoned.....

Date

1-30-35 192

ORVAL MANNSCHER Scout

Map No. 40 Sec. 23 Twp. 23 R. 4W

Well No. 3-Wilson

Amesbury Company

Contractor

SECTION PLAT


990 Ft. from N. Line

..... Ft. from S. Line

..... Ft. from E. Line

990 Ft. from W. Line



RECORD

Location.....

Rig up.....

Drilling and Remarks:

P.B. 3619  
1000 acid

1475 lbs

Cased..... in., ..... ft.

Sand Hurton 3604

Gas.....

Oil.....

Total Depth 3629

PRODUCTION

1st 24 hrs. Nat.....

1st 24 hrs. after shot.....

Gas..... Cu. Ft.

Dry Hole.....

Abandoned.....

Date

4-3-35 192

ORVAL MANNING Scout