


Section 23 Township 23 Range 12 W

Well No. # 1 Moulds

Company Lewis Drlg.

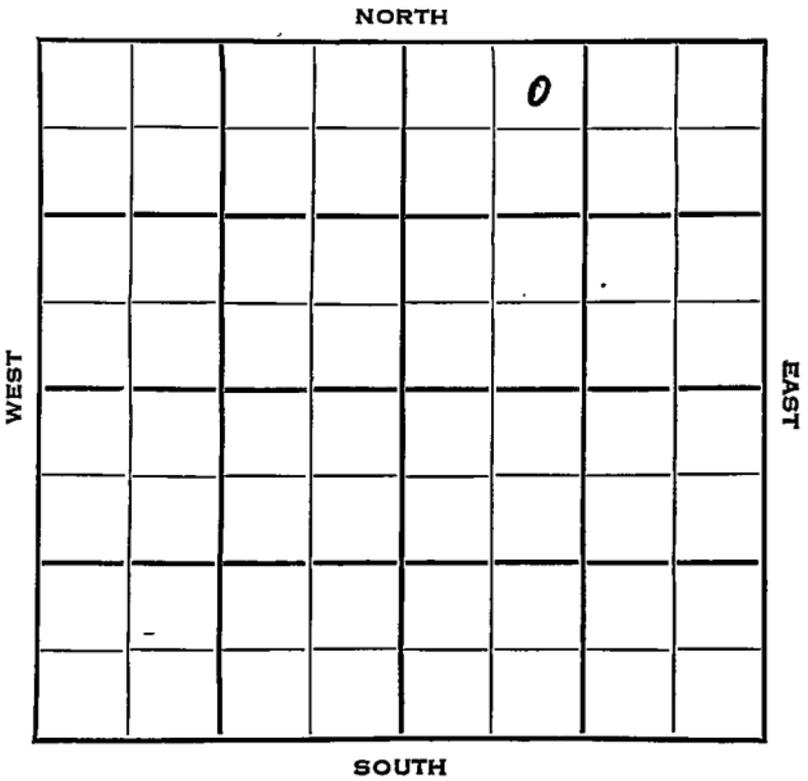

Sec. 23 Twp. 23 R. 12W

Well No. #1 Moulds Farm

Lewis Drlg. Company


Lewis Drlg. Contractor

330 Wildcat  
Ft. from N. Line

\_\_\_\_\_ Ft. from S. Line

\_\_\_\_\_ Ft. from E. Line

990 Ft. from W. Line

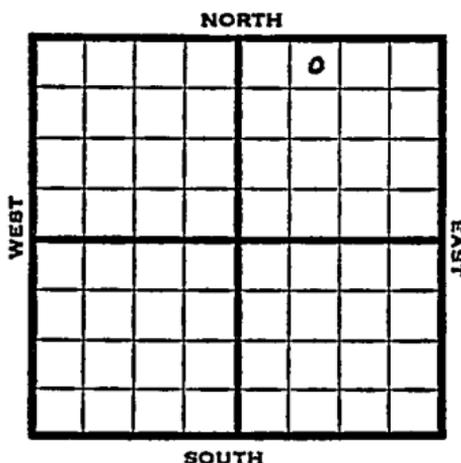

NE NW NE

1953 Elev. 1846' REPORT

5/20 Location

5/28 8" @ 172  
Anhy 610

6/3 Drlg. 2792  
 Spud 5-20-53 D & A TD 3880'  
 8" @ 172 Anhy 610 Heeb 3223  
 Br lime 3343 KC 3375  
 DST 3447-61 open 1 hr rec 165' gas  
 45' O & GCM, 30' SW 1150#  
 Cong 3696 Viola 3712  
 DST 3714-25 open 35 min rec 3' mud  
 15# Simp. 3753  
 DST 3725-62 open 3/4 hr. rec 15' mud  
 Arb. 3811 TD 3880 D & A

**ABANDONED**



