

Stafford

KANSAS

SECTION 23 TOWNSHIP 23 RANGE 12 W

WELL NO. #1 Lydia Thole

COMPANY Russell Cobb, Jr. (Tulsa)

NORTH

		0					

WEST

EAST

SOUTH

Stafford

KANSAS

SEC. 23	TWP. 23	R. 12W
------------	------------	-----------

WELL NO.

#1 Lydia Thole

FARM

COMPANY

Russell Cobb, Jr. (Tulsa)

CONTRACTOR

Thunderbird

WILDCAT


\_\_\_\_\_ Ft. from N. Line

\_\_\_\_\_ Ft. from S. Line

\_\_\_\_\_ Ft. from E. Line

\_\_\_\_\_ Ft. from W. Line

NW NE NW

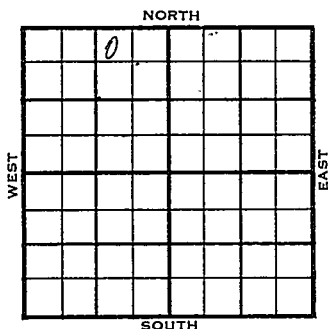

1956

ELEVATION

1848'

REPORT

1-11

Comm. 1-6-56  
8" @ 192/150  
Drlg. 2375'

1-18

D & A  
Log tops:  
H. 3201  
Bl. 3347  
L. 3376  
V. 3699  
S. 3758  
A. 3816  
TD 3850'

**ABANDONED**  
**ABANDONED**

County Stafford Elev. \_\_\_\_\_  
 Sec. 23 Twp. 23 Rge. 12W  
 Company Russell Cobb, Jr. (Tulsa)  
 Farm Name Lydia Thole No. 1

TOPS.	DEPTH	LOG	DATUM	Loc. in Sec.
Anh.				NW NE NW
T.P.				
H.				
Tr.				
Dg.				
Bl.				
L.				
K.C.				Geol. _____
B.K.C.				Contr. _____
Ce.				<u>Thunderbird</u>
C.				
M.				Pool _____
M.				<u>Wildcat</u>
K.				
Mz.				
Mo.				
V.				
S.				
S.				
A.				
R.				
Pc.				
G.				
T.D.				

JAN 11 1956  
 FIRST REPORT

Date Comm. 1-6-56  
8" @ 192/150 drlg. 2375

*[Handwritten signature and scribbles]*

Co.  
 Use.  
 No.  
 Sec.  
 T.  
 R.

County Stafford Elev. 1848  
 Sec. 23 Twp. 23 Rge. 12W  
 Company Russell Cobb, Jr. (Tulsa)  
 Farm Name Lydia Thole No. 1

TOPS	DEPTH	LOG	DATUM	Loc. in Sec.
Anh.				NW NE NW
TP.				
H.		3201		
Tr.				
Dg.				
BL.		3347		
L.		3376	1528	Geol.
K.C.				Contr.
B.K.C.				Thunderbird
Ce.				Pool
C.				Wildcat
M.				
M.				
K.				
Mz.				
Mq.				
V.		3699	1851	
S.		3758	1910	
S.				
A.		3816	1968	
R.				ABANDONED
PE.				
G.				
TD.	3850			

Date Comm. 1-6-56 JAN 18 1956  
8" @ 192/150

D & A

Co.  
Lse.  
No.  
Sec.  
T.  
R.