

Pawnee


DX 78-1

Sections

Section 23 Township 23S Range 15W

Well No. #1 Grizzell

Company Loffland Bros. et al

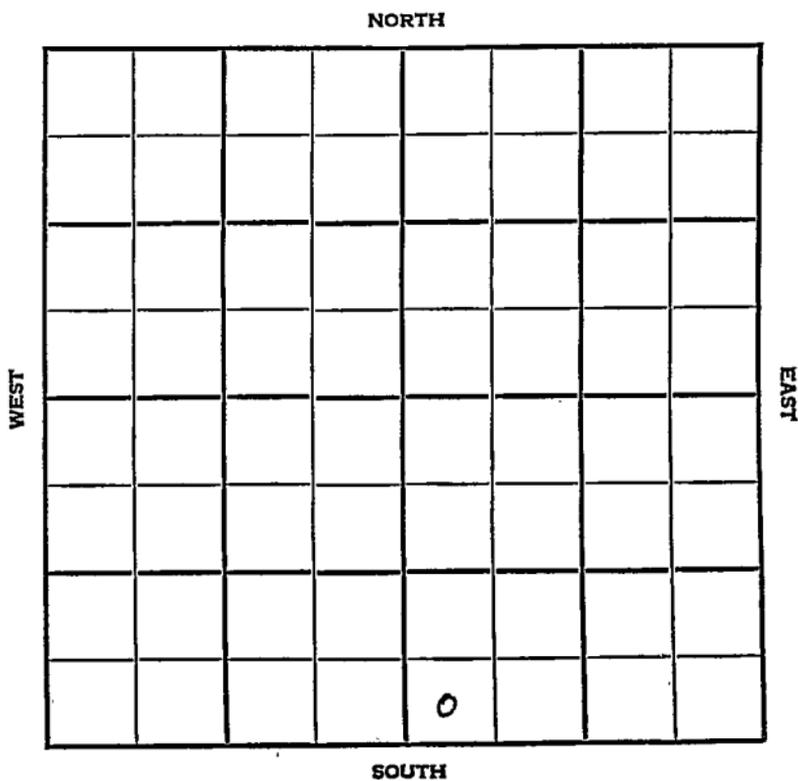

Pawnee


KANSAS

| | | |
|------|------|-----|
| SEC. | TWP. | R. |
| 23 | 23S | 15W |

WELL NO. #1 Grizzell FARM

COMPANY Loffland Bros. et al

CONTRACTOR

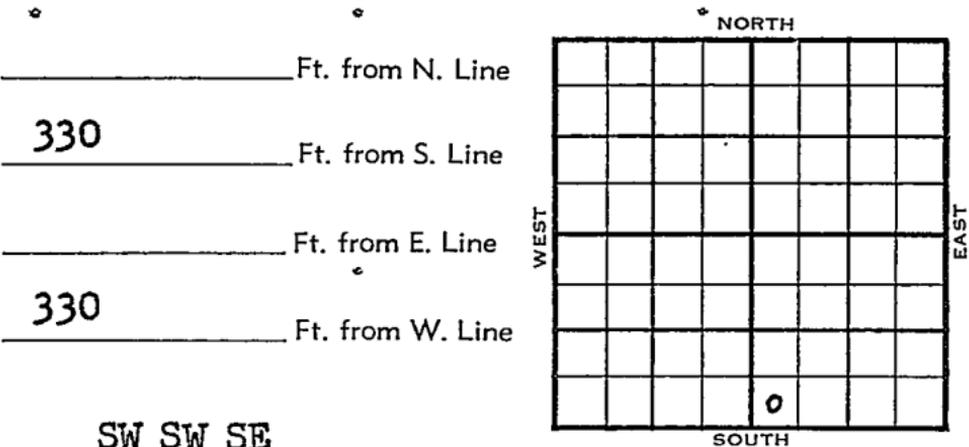

SW SW SE
Continental, Gulf & Natural - DHM

| | | |
|------|-----------|--------|
| 1954 | ELEVATION | REPORT |
| | 2010' | |

12/8 Location

1955
2/23 Spud 12-20-54 - Gas Well
TD 4149'
8" @ 252'
Heeb. 3476', Br lime 3615', Lans. 3628'
DST 3782-3806', opn 1 hr., rec. 80' wm, 1360#
Viola 3992'
DST 3992-4015', opn 1 hr., gas in 50", rec. 20' gcm, 740#
Simp. 4058', Simp. sd 4082'
DST ~~4060~~ 4060-4105', opn 1 hr., gas in 11", 250,000 cfg, 185' gcm, 1370#
DST 4105-15, failed
DST 4101-15, opn 2 hrs., 990' gas in pipe, rec. 62' gcm, 1250#
Arb. 4134'
DST 4132-40', opn 1 hr., gas in 4", 62,000 cf, 90' mud, 1545#
DST 4134-50', gas in 4", opn 28"
F/sul. wtr. in 25", 1350#
5" @ 4148'

OVER

(Information Brought Forward)

1955
2/23

Schl Tops:

Anhy 925', Heeb. 3475', Tor. 3497',
Doug. 3515', Iatan 3613', Lans 3624',
B KC 3862', Cong. 3951', Viola 3990',
Simp. Sh 4058', Simp. Sd 4082', Arb.
4134'

TD 4149'

CO to 4148'

60/4100-10

500 M-A

F/1,500,000 cfg, dec. to 1,200,000 cfg
1250#

sd-oil-frac

13/4084-88

DP 4120

1,800,000 cfg

Comp. SI Gas Well

1,634,000 cfgpd

COMPLETED

Drig. Data

SCHLUMBERGER TOPS:-

MISC

Anhy 925

Heeb. 3475

Top. 3475

Doug. 3515

Tatan 3613

Lans. 3624

B KC 3862

Conf. 3951

Viola 3990

Simp. sh. 4058

Simp. sh. 4083

Arb. 4134

TD 4149

60 to 4148

60/4100-80

500 M-A

F/ 1,500,000 cfg dec. to

1,200,000 cfg 1250# sd-oil-frac

13/ 4084-88 DP 4120 1,800,000 cfg.

Comp. ST gas well 1,634,000 cfgpd

MAR 1 1955