


DX 78-1 Finney

KANSAS

Section 23 Township 23 Range 32W
Well No. #1 Miller Gas Unit "D"
Company Petroleum Inc

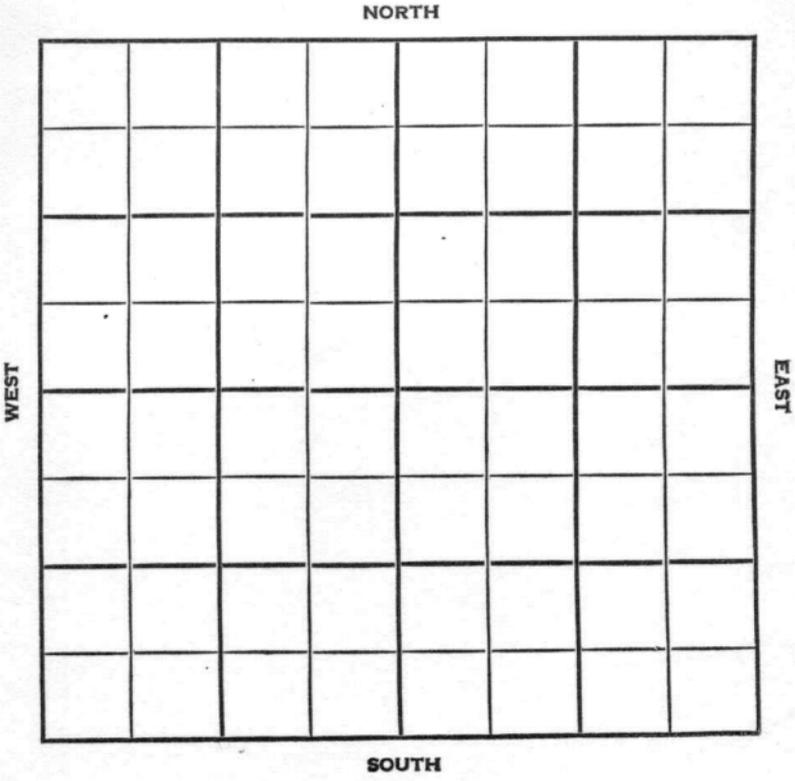

Finney

KANSAS

SEC. 23	TWP. 23	R. 32W
------------	------------	-----------

WELL NO. #1 Miller Gas Unit "D" FARM

COMPANY Petroleum Inc.

CONTRACTOR Garvey


Hugoton

_____ Ft. from N. Line

_____ Ft. from S. Line

_____ Ft. from E. Line

_____ Ft. from W. Line

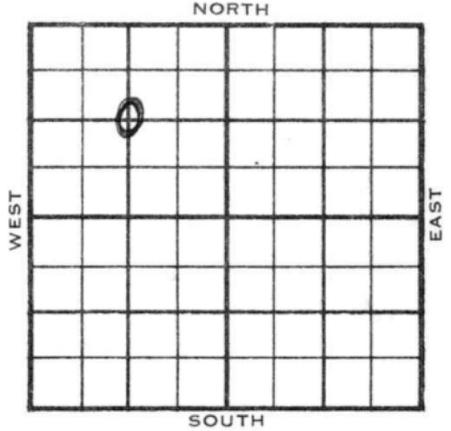

C NW/4

PEPE - FO

1956	ELEVATION 2917'	REPORT
------	--------------------	--------

3-21 Comm. 3-19-56
8" @ 258/225
WOC

4-25 5 1/2" @ 2708/650
CO to 2687, 26/ 2651-60, 51/ 2671-85
frac, 4300 mcfg, 1000 A
Comp. 9527mcfgpd, 421#
Herr. 2611
U. Kri. 2635
L. Kri. 2668
~~#####~~' TD 2710'

COMPLETED

County Finney Elev. 2917
 Sec. 23 Twp. 23 Rge. 32W
 Company Petroleum Inc.
 Farm Name Miller Gas Unit "D" No. 1


TOPS	DEPTH	LOG	DATUM
Anh. <u>Herr</u>	<u>2611</u>		
Tr. <u>u Kri</u>	<u>2635</u>		
Dg. <u>L Kri</u>	<u>2668</u>		
B.L.			
L.			
K.C.			
B.K.C.			
Ce.			
C.			
M.			
M.			
K.			
Mz.			
Me.			
V.			
S.			
S.			
A.			
R.			
PE.			
G.			
T.D.	<u>2710</u>		

Loc. in Sec. C NW/4

Geol. _____

Contr. Garvey

Pool Hugoton

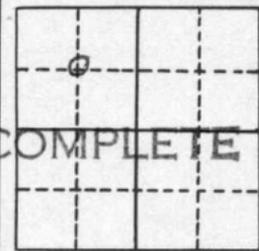

Date Comm. 3-19-56 APR 25 1956

8" @ 258/225 5 1/2" @ 2708/650
CO to 2687 26/ 2651-60 51/ 2671-85
frac 4,300 mcfg 1000 A
Comp. 9,527 mcfgpd 421#

Co.
Lse.
No.
Sec.
T.
R.