


KANSAS Finney

Section 23 Township 23 Range 34W

Well No. 1 Garden City "H"

Company Cities Service

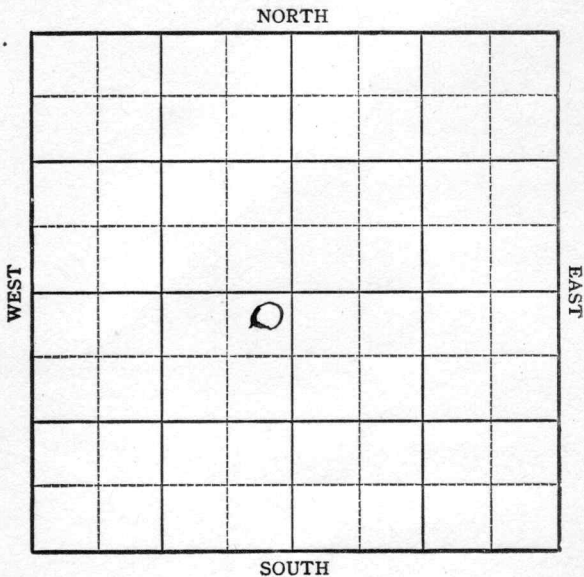

Sec. 23 Twp. 23 R. 34-W

Well No. #1 Garden City "H" Farm

Cities Service Company

Hugoton


100 Ft. from N. Line

 Ft. from S. Line

100 Ft. from E. Line

 Ft. from W. Line

NE SW

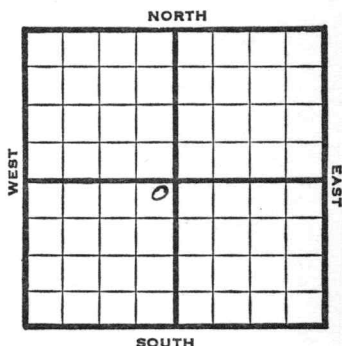

1948

Elev. 2936'

REPORT

8/11

Location

8/18

"

8/25

8" @ 760'

Drlg 2135'

9/1

TD 2615'

5" @ 2614'

9/8

"

9/14

"

9/21

160 shots 2564-96

130 " 2502-28

70 " 2468-72

60 " 2448-60

50 " 2422-32 - 35,000 acid

9/29

"

10/6

5" @ 2614'

Perf.

26,000 Acid

5,220,000 Gas

R. Pr. 426#

TD 2615'

COMPLETED

Finney County Kansas State
 Map No. _____ Sec. 23 Twp. 23 R. 34W

Well No. 1 Garden City "H"

Cities Service Company

FIRST REPORT Contractor

NE SW

SECTION PLAT

100 Ft. from N. Line

_____ Ft. from S. Line

100 Ft. from E. Line

_____ Ft. from W. Line

Hugoton Pool

Remarks:

Location

Date AUG 11 1948

Scout S. J. LEWIS

Map No. _____ Sec. 23 Twp. 23 R. 34W


Well No. 1 Garden City "H"

Cities Service _____ Company

COMPLETE _____ Contractor

NE SW

E 1,2986
SECTION PLAT

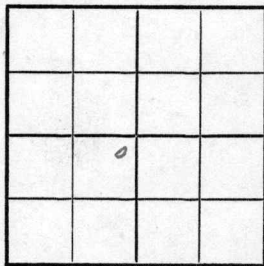

100 Ft. from N. Line

_____ Ft. from S. Line

100 Ft. from E. Line

_____ Ft. from W. Line

Finney County

Location _____

Rig up _____

Drilling and Remarks:

5" @ 2614

Per J.

26000 acid

5,220,000 gal

426 # RB

RECORD

Cased _____ in., _____ ft.

Sand _____

Gas _____

Oil _____

Total Depth 2615

PRODUCTION

1st 24 hrs. Nat. _____

1st 24 hrs. after shot _____

Gas _____ Cu. Ft.

Dry Hole _____

Abandoned _____

Date

OCT 6 1948 19 S. J. LEWIS Scout