


DX 78-1

Section 23 Township 23 Range 38W
Well No. #1 Gaeddert Gas Unit
Company Stanolind.

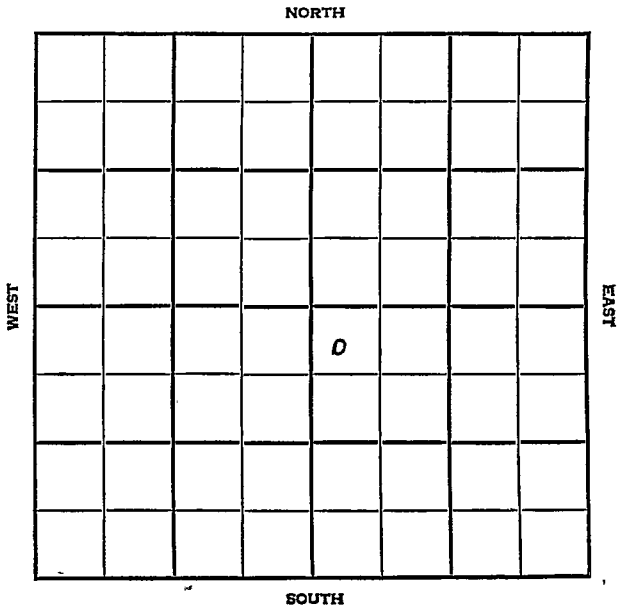

Kearny KANSAS

SEC.	TWP.	R.
23	23	38W

WELL NO.

1 Gaeddert Gas Unit FARM

COMPANY

Stanolind

CONTRACTOR

Barbour


Hugoton Pool

150 Ft. from N. Line

Ft. from S. Line

Ft. from E. Line

150 Ft. from W. Line

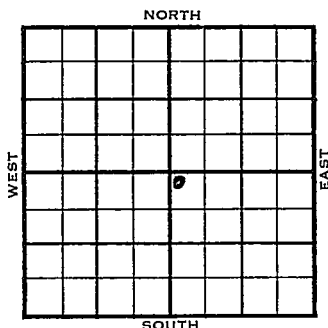

NW NW SE


	ELEVATION	REPORT
1955	3346'	

3/9 Location

4/13 Spud 3-10-55 - Gas Well
 TD 2719'
 Her. 2600', Win. 2658'
 TD 2719'
 5" @ 2700'
 CO to 2719 stratofrac
 150A stratofrac 1500A
 600,000 cfg 5 gw SP 2682
 30/2674-79 66/2658-69 190,000 cfg
 300,000 cfg 30 gwph 700A
 stratofrac 1,982,000 cfgpd 12 gwph
 16/2623-27 28/2632-39 56/2600-14
 700A 2,209,000 cfg 26 gwph 48 hrs
 Comp. 6,786,000 cfgpd 347#

COMPLETED

FABEN GILSTRAP

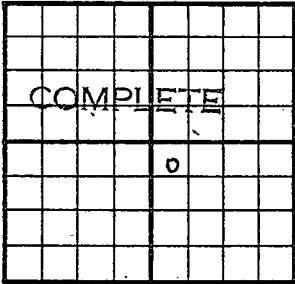County	Kearny		State	Kansas	
Sec.	23	(Blk. Twp.)	23	(Sur. Rge.)	38W Map No.
Operator	Stanolind				
Well No.	1	Farm	Gaeddert Gas Unit		
Elev.	3346	Location	NW NW SE		
			150 Ft. From N Line SE		
			150 Ft. From W Line Quarter		
			1st. Report		
			Completion APR 13 1955		
			Remarks Hugoton Pool		
			Barbour - Contr.		
			Spudding Date 3-10-55		

Drilg. Data	Gas well		TD 2719	
Her. 2600	Win. 2658	TD 2719		
5" @ 2700	CO to 2719	stratofrac		
150 A	stratofrac	1500 A	600,000 cfg	
5 gw	SP 2682	30/ 2674-79	66/ 2658-69	
190,000 cfg	300,000 cfg	30 gwph		
700 A	stratofrac	1,982,000 cfgpd		
12 gwph	16/ 2623-27	28/ 2632-39		
56/ 2600-14	700 A	2,209,000 cfg		
26 gawph	48 hr.			
Comp. 6,786,000	cfgpd	347#		

FABEN GILSTRAP