

STATE CORPORATION COMMISSION OF KANSAS
OIL & GAS CONSERVATION DIVISION
WELL COMPLETION OR RECOMPLETION FORM
ACO-1 WELL HISTORY
DESCRIPTION OF WELL AND LEASE

Operator: License # 4808
Name Smokey Oil Company
Address P. O. Box 2360
City/State/Zip Casper, WY 82602

Purchaser

Operator Contact Person C. F. Pickard
Phone 307-266-0230

Contractor: License # 4708
Name True Drilling Company

Wellsite Geologist Roger Matson
Phone 303-741-1231

Designate Type of Completion
 New Well Re-Entry Workover
 Oil SWD Temp Abd
 Gas Inj Delayed Comp.
 Dry Other (Core, Water Supply etc.)

If OWNED: old well info as follows:
Operator
Well Name
Comp. Date Old Total Depth

WELL HISTORY

Drilling Method:
 Mud Rotary Air Rotary Cable
2/26/86 3/3/86 3/4/86
Spud Date Date Reached TD Completion Date
4725 None
Total Depth PBTD

Amount of Surface Pipe Set and Cemented at 602 feet
Multiple Stage Cementing Collar Used? Yes No
If yes, show depth set feet
If alternate 2 completion, cement circulated from feet depth to w/SX cmt
Cement Company Name Halliburton
Invoice # 100721

API NO. 15-083-21,242
County Hodgeman
C NE NE Sec. 28 Twp. 23 Rge. 24 East West

4620 Ft North from Southeast Corner of Section 28
660 Ft West from Southeast Corner of Section 28
(Note: Locate well in section plat below)


Lease Name Bently Well # 41-28

Field Name Wildcat

Producing Formation

Elevation: Ground 2387 KB 2402

Section Plat

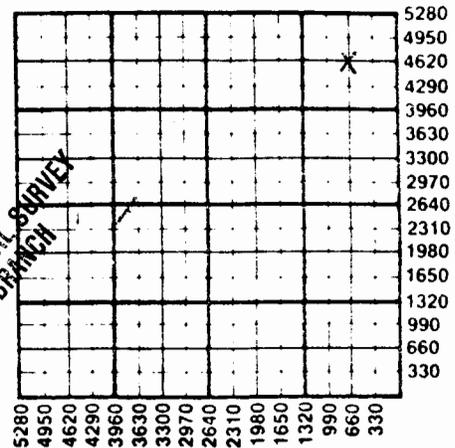

WATER SUPPLY INFORMATION
Disposition of Produced Water: N/A Disposal
Docket # Repressuring

Questions on this portion of the ACO-1 call:
Water Resources Board (913) 296-3717

Source of Water:
Division of Water Resources Permit #

Groundwater Ft North from Southeast Corner (Well) Ft West from Southeast Corner of Sec Twp Rge East West

Surface Water Ft North from Southeast Corner (Stream, pond etc) Ft West from Southeast Corner Sec Twp Rge East West

Other (explain) Private landowner - water well (SW 1/4 Sec. 9-T11N-R58W) (purchased from city, R.W.D. #)

INSTRUCTIONS: This form shall be completed in triplicate and filed with the Kansas Corporation Commission, 200 Colorado Derby Building, Wichita, Kansas 67202, within 120 days of the spud date of any well. Rule 82-3-130, 82-3-107 and 82-3-106 apply. Information on side two of this form will be held confidential for a period of 12 months if requested in writing and submitted with the form. See rule 82-3-107 for confidentiality in excess of 12 months. One copy of all wireline logs and drillers time log shall be attached with this form. Submit CP-4 form with all plugged wells. Submit CP-111 form with all temporarily abandoned wells.

SIDE TWO

Operator Name Smokey Oil Company Lease Name..... Bently Well #..... 41-28
 Sec..... 28 Twp..... 23S Rge..... 24 East
 West County..... Hodgeman

WELL LOG

INSTRUCTIONS: Show important tops and base of formations penetrated. Detail all cores. Report all drill stem tests giving interval tested, time tool open and closed, flowing and shut-in pressures, whether shut-in pressure reached static level, hydrostatic pressures, bottom hole temperature, fluid recovery, and flow rates if gas to surface during test. Attach extra sheet if more space is needed. Attach copy of log.

Drill Stem Tests Taken Yes No
 Samples Sent to Geological Survey Yes No
 Cores Taken Yes No

Formation Description
 Log Sample

Name	Top	Bottom
Stone Corral	1595	
Neva	2893	
Topeka	3453	
Heebner	3952	
Lansing	4000	
Kansas City	4214	
Marmaton	4488	
Cherokee	4568	
Mississippian	4684	

CASING RECORD <input checked="" type="checkbox"/> New <input type="checkbox"/> Used							
Report all strings set-conductor, surface, intermediate, production, etc.							
Purpose of String	Size Hole Drilled	Size Casing Set (in O.D.)	Weight Lbs/Ft.	Setting Depth	Type of Cement	#Sacks Used	Type and Percent Additives
Surface	12 1/2	8-5/8	24#	602	Lite Class A	175 100	3% CaCl "
PERFORATION RECORD				Acid, Fracture, Shot, Cement Squeeze Record			
Shots Per Foot	Specify Footage of Each Interval Perforated			(Amount and Kind of Material Used)		Depth	
TUBING RECORD				Liner Run <input type="checkbox"/> Yes <input type="checkbox"/> No			
Date of First Production	Producing Method						
<input type="checkbox"/> Flowing <input type="checkbox"/> Pumping <input type="checkbox"/> Gas Lift <input type="checkbox"/> Other (explain).....							