


Map No. KANSAS Sec. 24 Twp. 23 R. 3 ^W

Well No. 1-Ingalls Farm
Rosenthal et al Company

NORTH

WEST

EAST

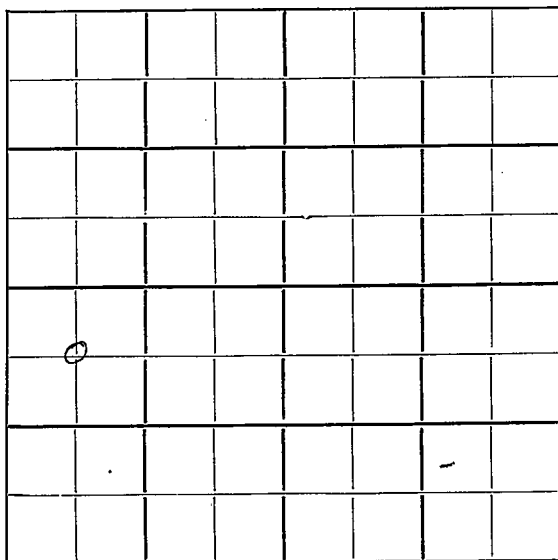

SOUTH

Location.....

Drilling Remarks

Rig Up.....

Drilling Remarks

RECORD

Cased.....in.....ft.

Sand.....

Gas.....

Oil.....

Total Depth.....

PRODUCTION

1st 24 hrs. Nat.....

1st 24 hrs. after shot.....

Gas.....cu. ft.....

Dry Hole.....

Abandoned.....


Map No. KANSAS Sec. 24 Twp. 23 R. 3^W
 Well No. 1- Ingalls Farm
Rosen:thal et al Company

660 Ft. from N. Line

_____ Ft. from S. Line

_____ Ft. from E. Line

660 Ft. from W. Line

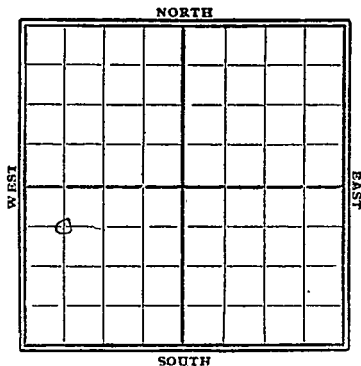

1929

Date	REPORT
2/13	Rod
2/20	Bldg Rig
2/27	Rig
3/6	Rig in op.
3/13	Spd 145'
3/20	Spud 300'
3/27	Drill 820'
4/3	set 12"- 1400'
4/10	Drill 1400'
4/17	SD 1400' T.D.
4/24	—
5/1	—
5/8	—
5/15	—
5/22	Drill 1830'
5/29	HFW 2340 - T.D. 2370 - S.P
6/5	Rig burned
6/12	Bldg Rig
6/19	—
6/26	Drill 2540'
7/2	2835
7/10	UIR 8"- 2950'

7/17- Chat 3209-10'

T.D. 3224-UR 8"

7/24- Plg out 3395'

7/31- S.D. 3395'

8/7- Top line 3333'

HFW 3395'

T.D. 3425' Rng 6" csg.

8/14- HFW 3455-70

Wrg 3475

8-21- drelg 3710

8/28- Show oil 3840-50

T.D. 3860 - S.D.

9/4 -

9/11- HFW 3910-40

Wrg 4025

9/18- T.D. 4060'

Dry & Abandoned

MAP No. KANSAS SEC. 24 TWP. 23 R. 3 W

WELL No. 1622 Ingalls

Rosenblatt & Co. COMPANY

CONTRACTOR

SECTION PLAT

0			

660 FT. FROM N. LINE

FT. FROM S. LINE

FT. FROM E. LINE

660 FT. FROM W. LINE

FIRST REPORTS

LOCATION _____

RIG UP _____

DRILLING AND REMARKS:

ROH

RECORD

CASED _____ IN. _____ FT.

SAND _____

GAS _____

OIL _____

TOTAL DEPTH _____

PRODUCTION

1ST 24 HRS. NAT. _____

1ST 24 HRS. AFTER SHOT _____

GAS _____ CU. FT.

DRY HOLE _____

ABANDONED _____

DATE

FEB 13 1920

192

S. J. LEWIS

SCOUT

Harvey
 Map No. KANSAS Sec. 24 Twp. 23 R. 3W

39
 Well No. Ingalls

Rosenthal & Co Company

Contractor

SECTION PLAT

660 Ft. from N. Line

..... Ft. from S. Line

..... Ft. from E. Line

660 Ft. from W. Line

0			

ABANDONED

Location.....

Rig up.....

Drilling and Remarks:

RECORD

Cased.....in.,ft.

Sand.....

Gas.....

Oil.....

Total Depth 4060

PRODUCTION

1st 24 hrs. Nat.....

1st 24 hrs. after shot.....

Gas.....Cu. Ft.

Dry Hole.....

Abandoned.....

Date

SEP 18 1929

192

S. J. LEWIS Scout